

**TMUA PROJECT No. WPC 23-3,
FY '23 NORTHSLOPE CAPITAL EQUIPMENT REPLACEMENTS**

ATTENDANCE AT PRE-BID CONFERENCE IS MANDATORY

PREPARED BY:
MASARU BROOK IWATA, P.E.
CITY OF TULSA WATER AND SEWER DEPARTMENT
5628 N. 105TH E. AVE., TULSA, OK 74117
918-591-4714 OFFICE, 918-699-3082 FAX
MIWATA@CITYOFTULSA.ORG



Account Numbers: 7503392 544003

Masaru Brook Iwata
Masaru Brook Iwata, P.E. OK#28906
Matt Vaughan
Matt Vaughan, P.E. OK#19788

Feb 13, 2023
Date
2.13.23
Date

ERIC LEE, DIRECTOR
WATER AND SEWER DEPARTMENT


Eric Lee, Director, Water & Sewer Dept.

2.14.2023
Date

Note: The Drawings attached hereto as part of these Specifications are for information purposes only. The Authority makes no representation or guarantee with respect to the accuracy of any information contained in the Drawings. It is the Contractors responsibility to verify information on the drawings to ensure the equipment installed or controlled by work performed under this Contract performs as specified herein.

Water and Sewer Department
175 E. 2nd Street
Tulsa, Oklahoma 74103
(918) 596-9845

DRAWINGS

Index of Drawings

Drawing	Title
214.1A	Aeration Basin #4 Diffusers (key Plan)
214.1B	Aeration Basin #4 Diffusers (Grid Type 1)
214.1C	Aeration Basin #4 Diffusers (Grid Type 2)
214.1D	Aeration Basin #4 Diffusers (Grid Type j)
214.1E	Aeration Basin #4 Diffusers (Grid Type 4)
214.1F	Aeration Basin #4 Diffusers (Grid Type 5)
214.1G	Aeration Basin #4 Diffusers (Grid Type 6)
214.1H	Aeration Basin #4 Diffusers (Grid Type 7)
214.1I	Aeration Basin #4 Diffusers (Grid Type 8)
214.1J	Aeration Basin #4 Diffusers (Grid Type 9)
214.2A	PEW Pump Suction, Discharge, Valve and Pipe Painting
214.2B	PEW Pump Suction and Discharge Valve Replacement
214.3A	Chemical Pump Replacement Overview
214.4A	Aeration Basin 4 Air Valve Actuator Replacement
214.5A	Chemical feed line replacement
214.5B	Chemical feed line replacement

Index of Equipment

Spec Sect	Equipment ID	Equipment Description	Equipment Status
214.1	EA	Aeration Basin #2 Diffusers	Replaced
214.2	N060-PEW1-BFV06	PEW INLET BUTTERFLY VALVE	Replaced
214.2	N060-PEW1-BFV07	PEW INLET BUTTERFLY VALVE	Replaced
214.2	N060-PEW1-BFV08	PEW INLET BUTTERFLY VALVE	Replaced
214.2	N060-PEW1-BFV09	PEW INLET BUTTERFLY VALVE	Replaced
214.2	N060-PEW1-BFV10	PEW OUTLET BUTTERFLY VALVE	Replaced
214.2	N060-PEW1-BFV11	PEW OUTLET BUTTERFLY VALVE	Replaced
214.2	N060-PEW1-BFV12	PEW OUTLET BUTTERFLY VALVE	Replaced
214.2	N060-PEW1-BFV13	PEW OUTLET BUTTERFLY VALVE	Replaced
214.2	N060-PEW1-CKV01	PEW OUTLET CHECK VALVE	Replaced
214.2	N060-PEW1-CKV02	PEW OUTLET CHECK VALVE	Replaced
214.2	N060-PEW1-CKV03	PEW OUTLET CHECK VALVE	Replaced
214.2	N060-PEW1-CKV04	PEW OUTLET CHECK VALVE	Replaced
214.3	N060-CHL1-MTP01	BLEACH BUILDING CHEMICAL PUMP	Replaced
214.3	N060-CHL1-MTP02	BLEACH BUILDING CHEMICAL PUMP	Replaced
214.3	N060-CHL1-MTP03	BLEACH BUILDING CHEMICAL PUMP	Replaced
214.4	N040-ARB4-ACT01	AB4 ACTUALTOR	Replaced
214.5		CHEMICAL FEED LINE	Replaced
214.5		DUCK BILL CHECK VALVE	Replaced

Index Of Drawings
 WPC 23-3



AERATION BASIN #4
DIFFUSER REPLACEMENT SPEC # 214.1
AIR VALVE ACTUATOR SPEC # 214.4

BLEACH BUILDING & CONTACT BASINS
PEW VALVE REPLACEMENT & PAINT SPEC # 214.2
CHEMICAL PUMP REPLACEMENT SPEC # 214.3
CHEMICAL FEED LINE & DUCK BILL CHECK VALVE REPLACEMENT SPEC # 214.5

Locations of
Projects
WPC 23-3

Northside Wastewater
Treatment Plant


N 105th E Ave

N 103rd

Notes:
 Remove & Replace
 214.1.6 Diffuser Assemblies shall be model Silver Series II 9" Membrane Disc Diffusers manufactured by Sanitaire, EDI or approved equal Contractor to order enough EPDM orifice plugs for the called out blanks. Any unused plugs will be given to the plant.

214.1.7 **INSTALLATION:** Diffuser Assemblies and Retainer Rings shall be installed per manufacturers instructions including the following noted steps and concerns.
 1. Before installation on a given row of diffusers, Contractor is to remove the diffusers to be replaced and flush out existing piping.
 2. **It is extremely important not to over-torque the retainer rings during installation.**
 3. Contractor is to report any assemblies that are missing plates, so that City personnel can purchase for replacement at a later time.
 4. Contractor to report any existing diffuser holders or piping that has existing damage, so that City personnel can purchase for replacement at a later time. Contractor will be responsible for any existing holders or piping that is damaged during install.
 5. Contractor Hydraulically clean airlines free of any / all debris.

214.1.8 **TESTING:** The diffuser assemblies shall be installed in strict conformance with the manufacturer's recommendations, which are to be submitted with the shop drawings. After completion of the installation, the diffuser assemblies shall be tested by the Contractor under actual operating conditions. An Authorized Manufacturer's Representative shall do onsite verification of diffusers at Start-Up and provide a report on transfer efficiency.

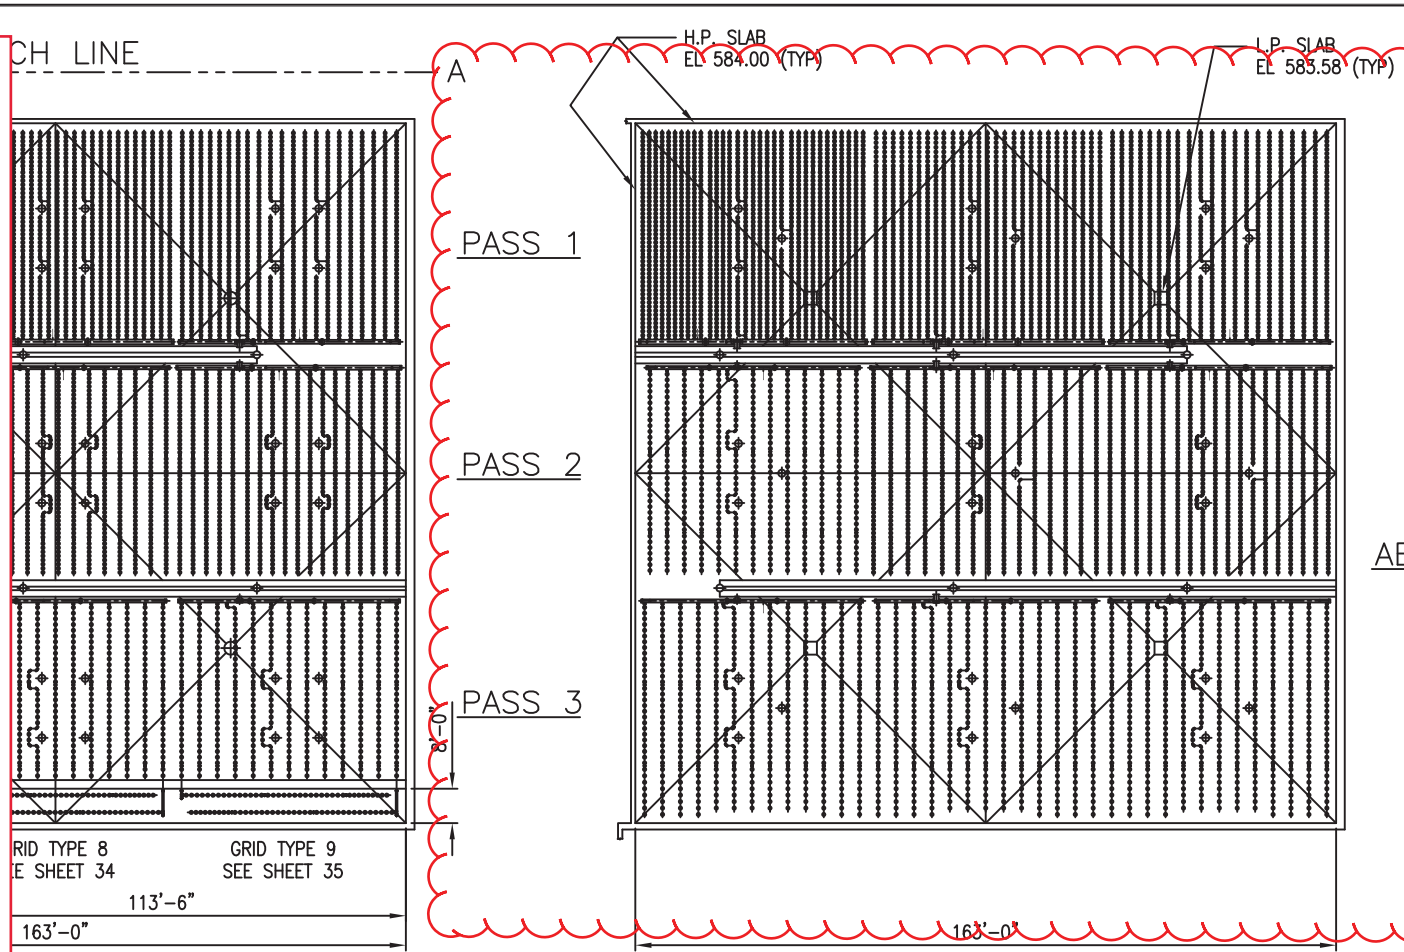

MEMBRANE DISC AERATION SYSTEM MATERIAL AND MANUFACTURING SPECIFICATIONS (304L PVC)			
ITEM	MATERIAL SPECIFICATION	MANUFACTURING SPECIFICATION	NOTES
DROPLEG	304L STAINLESS STEEL ASTM A242	FITTINGS: TUBULAR PRODUCTS: ASTM A776 DIMENSIONS: ASTM A584	150# DRILLING FOR TERMINATION FLANGE CONNECTION. SCH 10 PIPE WALL THICKNESS ON DROPLEG. *SEE BELOW
SUPPORTS	3/16" SWELLS ST SIZES & PAGES PER ASH 420 THREADED RODS PER ASH A276		1" GRADE NOT REQUIRED FOR NON-WELDED PARTS
BOLTS, NUTS, WASHERS	304 STAINLESS STEEL		
FIXED JOINT O-RING	NATURAL RUBBER/SBR		45 ± 5 DUROMETER SHORE A COMPRESSION SET 15% MAX.
EXPANSION JOINT O-RING	NATURAL RUBBER/SBR		40 ± 5 DUROMETER SHORE A 0.45 COEFFICIENT OF FRICTION MAX.
LOWER DROPLEG & MANIFOLD	PVC, ASTM D1774 COMPOUND 12454-B	PIPE: ASTM D1785 FITTINGS: ASTM D2486	
AIR DISTRIBUTORS	PVC, ASTM D3915 COMPOUND 12452-4	PIPE: ASTM D3034 FITTINGS: ASTM D3034	MINIMUM 2% TITANIUM DIOXIDE
DIFFUSER HOLDER SUBPLATE, RETAINING RING	PVC, ASTM D3915 COMPOUND 12454-4		MINIMUM 2% TITANIUM DIOXIDE
DIFFUSER ELEMENT	EPDM		
PVC SOLVENT WELDING	ASTM D2554	ASTM D2855	

*STAINLESS STEEL DROPLEG FABRICATION
 FACTORY WELD ONLY WITH MIG, TIG, OR PLASMA-ARC WELDING INERT GAS PROCESSES, FULL PENETRATION BUTT WELDS, ER 316L FILLER WIRE. AFTER FABRICATION FINISH CLEAN ALL WELDED STAINLESS STEEL ASSEMBLIES BY FULL IMMERSION CLEANING TECHNIQUES IN ACCORDANCE TO 6.2.11 OF ASTM A380-99. THE ACID FOR USE DEFINED BY TABLE A2.1 OF ANNEX A2 OF ASTM A380. FINAL RINSE AND DRY IN ACCORDANCE TO SECTION 8.3 OF ASTM A380. ALL WELDED SURFACES TO CONFORM TO AISI NO. 2D FINISH.

AERATION BASIN 4
 BASIN 4 IS A MIRROR
 IMAGE OF BASIN 3



AERATION BASIN 1

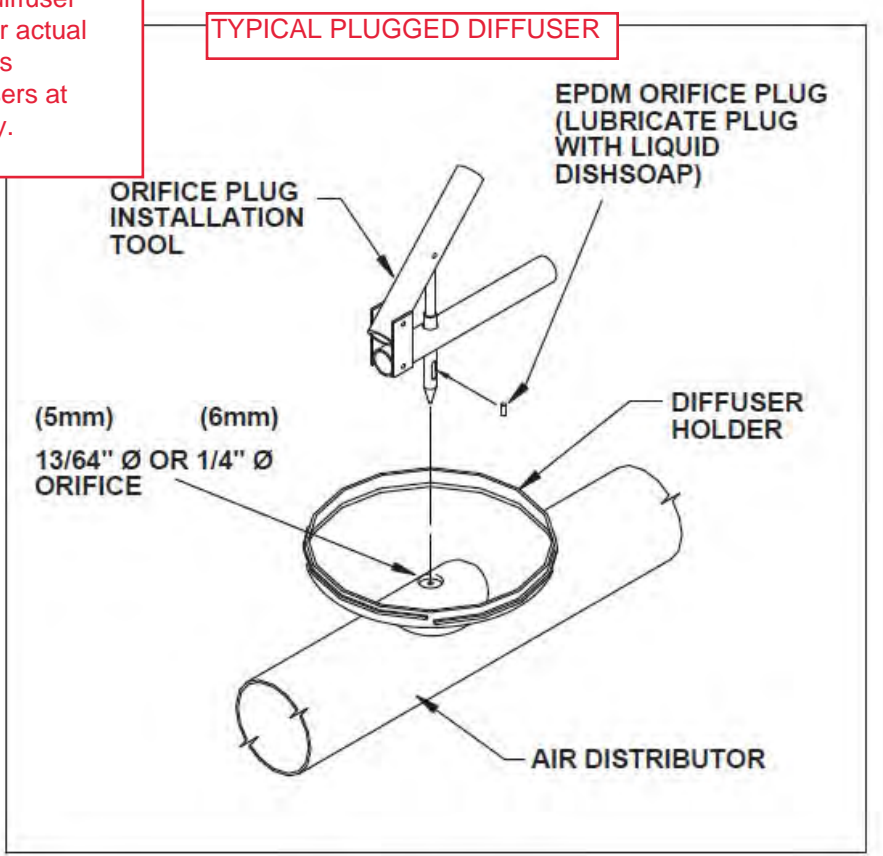
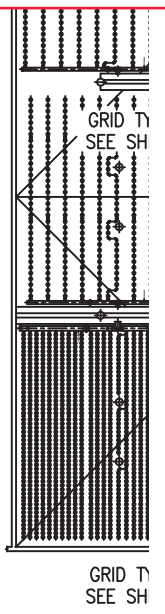


Figure 37

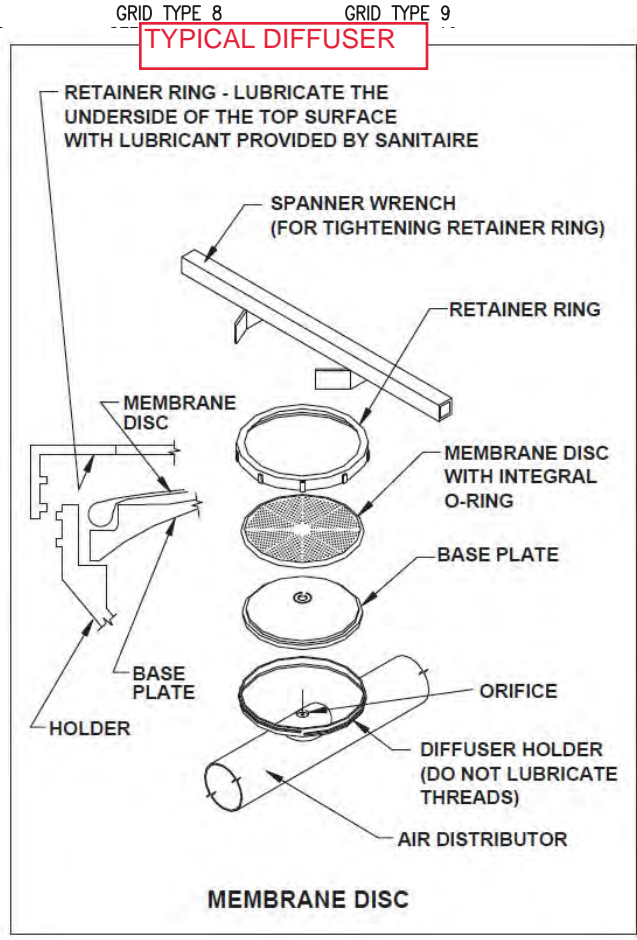


Figure 36

Aeration Basin #4
 Diffuser
 Replacements

IN BASIN 3

VIEW, SECTION OR
 DETAIL NUMBER
 2/3
 SHEET NUMBER ON WHICH
 VIEW, SECTION OR DETAIL
 IS FOUND

4				
3				
2				
1				
NO.	DATE	REVISION	BY	

TULSA, OK
 NORTHSIDE WWTP

THIS DRAWING IS THE PROPERTY OF SANITAIRE AND IS SUBMITTED IN CONFIDENCE. IT IS TO BE KEPT IN THE OFFICE OF THE ENGINEER AND NOT TO BE REPRODUCED OR COPIED IN ANY MANNER WITHOUT THE WRITTEN CONSENT OF SANITAIRE.

**WPC 23-3
 214.1A**

NOTE: SUPPORT SPACING

Every attempt has been made to insure locational dimensions of the supports are correct. However, after one line of air distributor anchors for any grid type have been installed, the locations must be checked for proper clearances by installing the supplied air headers. Spacing between lines must be checked for fit with the cross manifold and drain line. Any discrepancies or interferences must be brought to the attention of SANITAIRE prior to further installation.

The actual support anchor locations must be indexed from the centerline of the manifold. The actual accumulative dimensional error from the manifold to the anchor bolt must not exceed $\pm 3/4"$.

NOTE:
 This sheet shows the existing 1546 diffuser holders in Aeration Basin #4, Grid 1 of which 1450 existing holders have diffuser elements installed and 96 "blank" diffusers.
 Contractor to install NEW diffuser elements in only 816 of the 1450 existing holders with old diffuser elements and make the remaining 634 holders "blank" diffusers (in addition to the existing "blank" diffusers).
 Please see the key for locations of new diffuser elements and new "blank" diffusers.

- 2 - TANK(S)
- 1 - GRID(S) PER TANK
- 32 - AIR DISTRIBUTORS PER GRID
- VARIABLES - DIFFUSER HOLDERS PER AIR DISTRIBUTOR
- 1546 - TOTAL DIFFUSER HOLDERS PER GRID
- VARIABLES - DIFFUSER ELEMENTS PER AIR DISTRIBUTOR
- 1450 - DIFFUSER ELEMENTS INSTALLED PER GRID
- 2900 - TOTAL DIFFUSER ELEMENTS INSTALLED FOR THIS GRID TYPE
- 96 - TOTAL BLANK DIFFUSERS PER GRID


*subject to manufactures final recommendations

- LEGEND**
- FJ - FIXED JOINT
SEE DETAIL FB-10A
SHEET- 29
 - GS - GUIDE SUPPORT
SEE DETAIL SUP-2
SHEET- 31
 - FOR TYPICAL AIR DISTRIBUTOR SECTION
SEE DETAIL FB-22C
SHEET- 29

4			
3			
2			
1			
NO.	DATE	REVISION	BY

TULSA, OK
 NORTHSIDE WWTP

WPC 23-3
214.1B

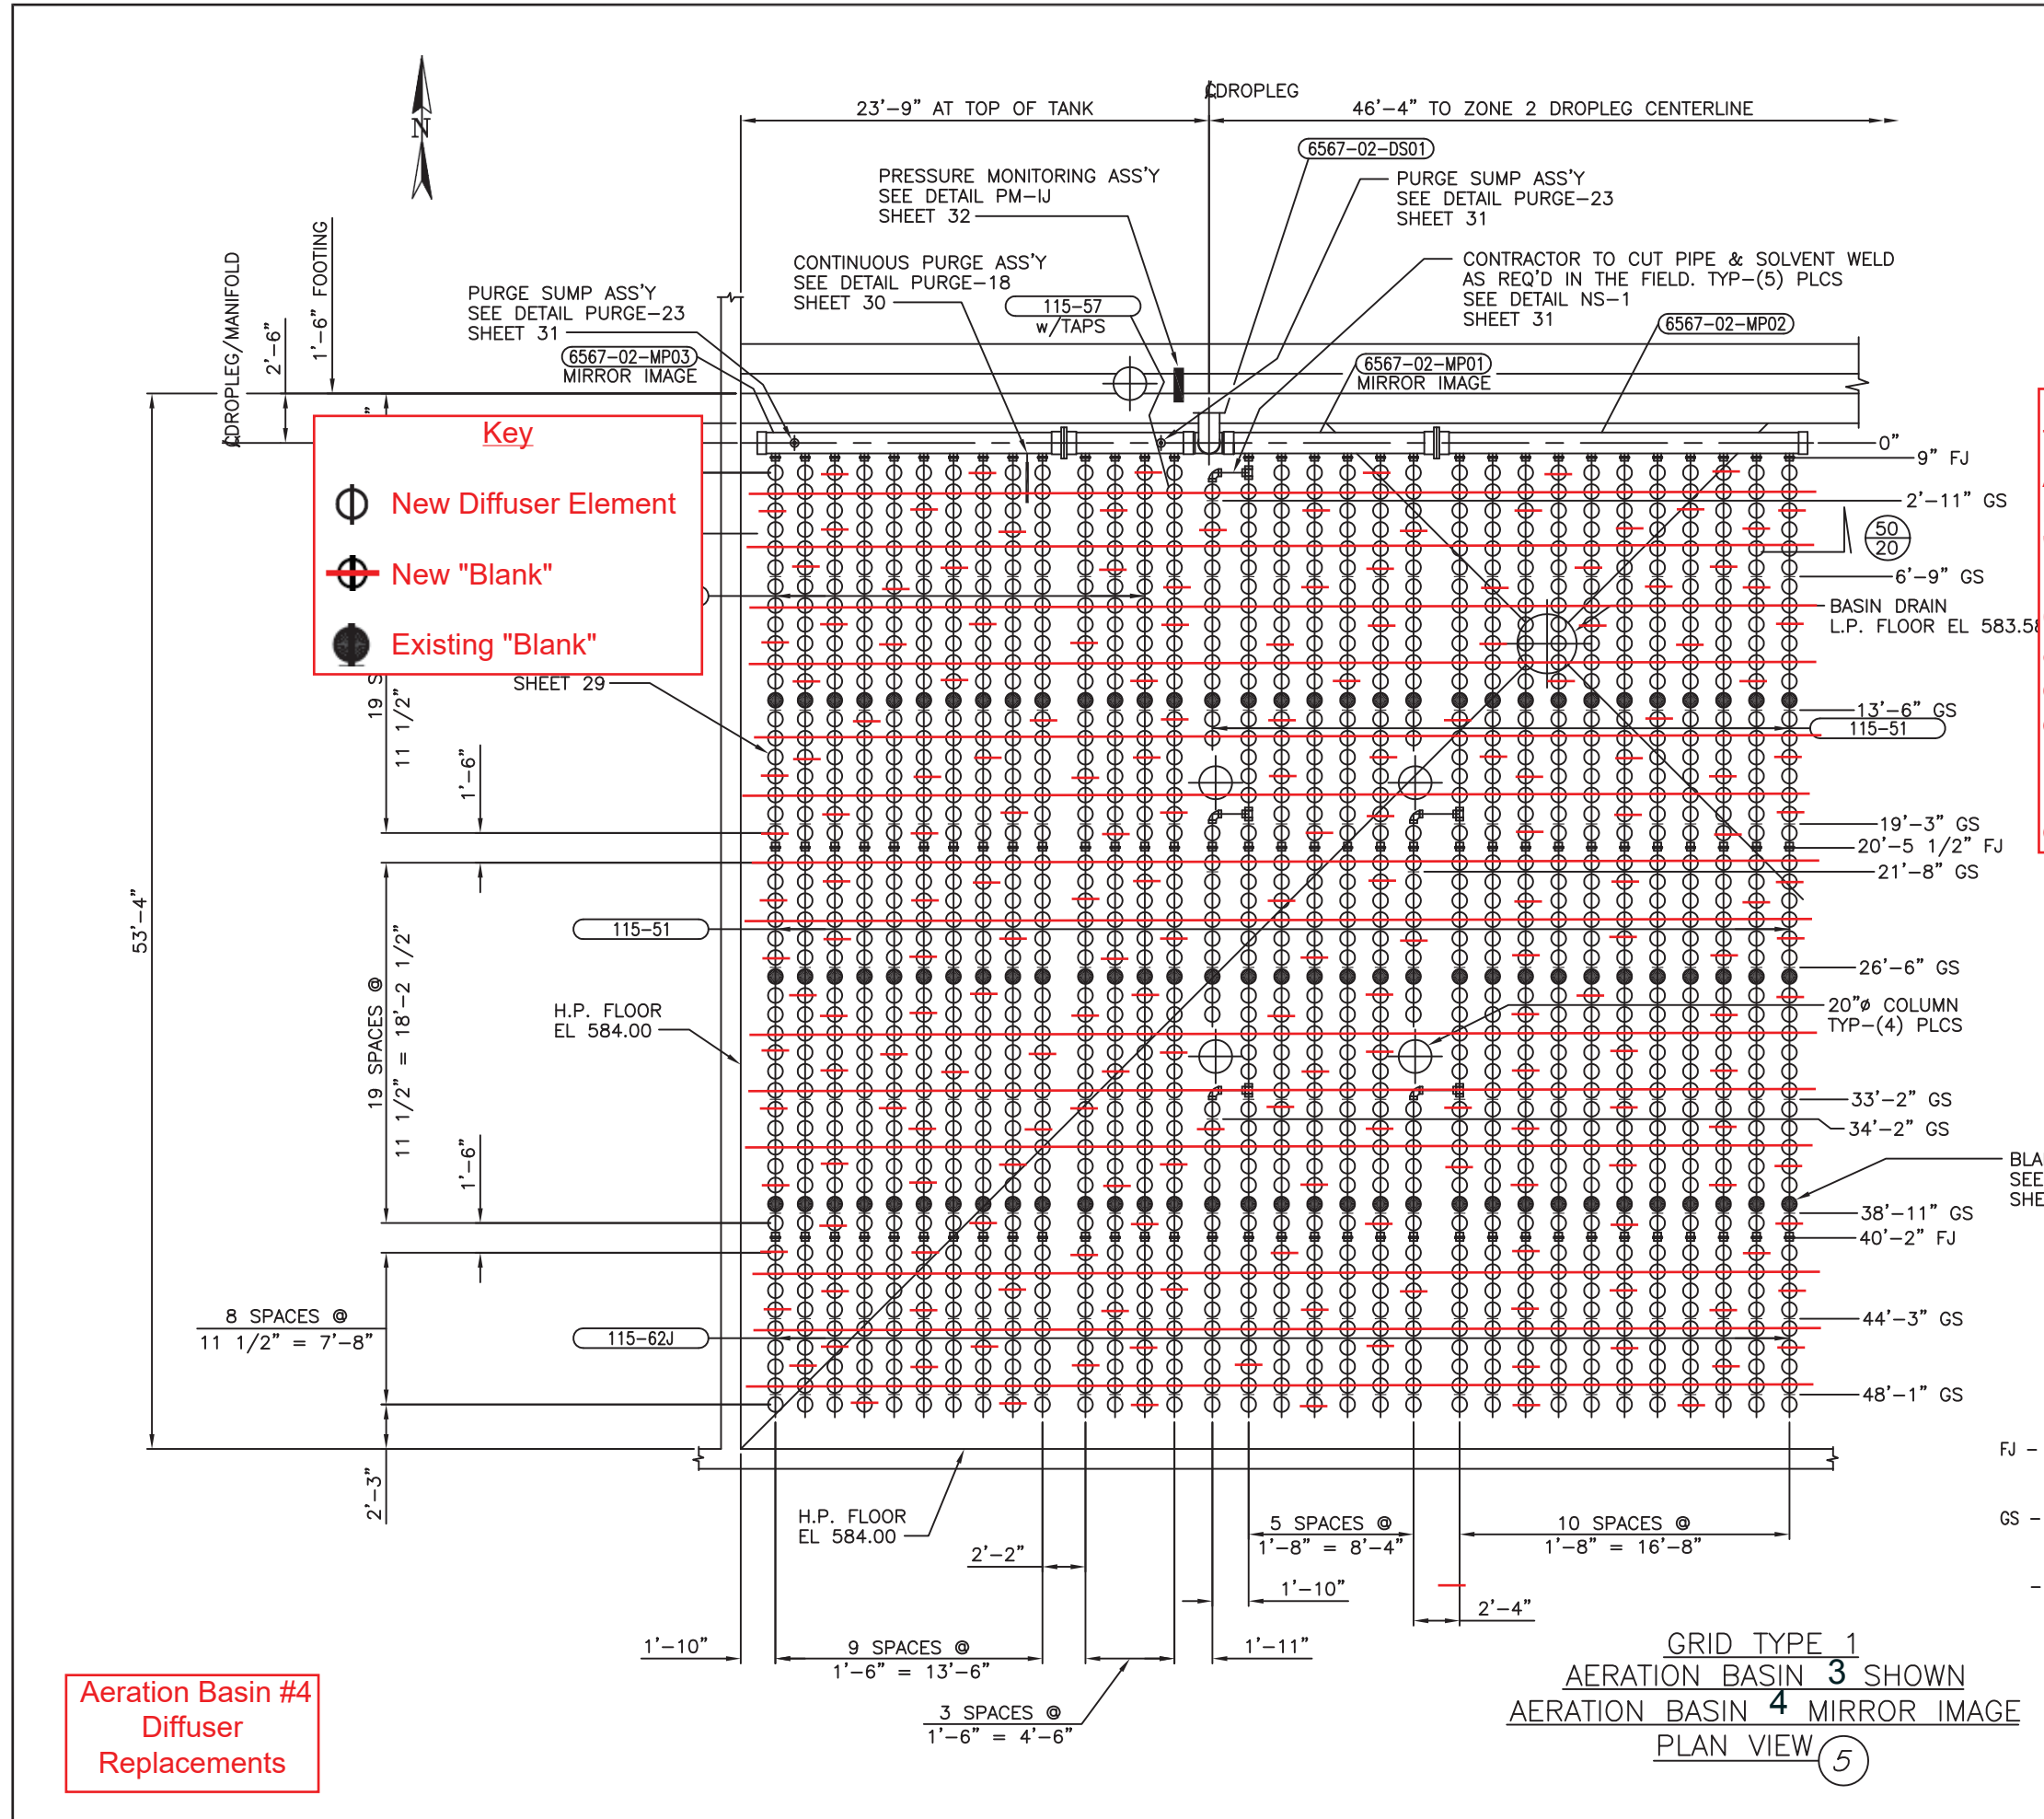

**Aeration Basin #4
 Diffuser
 Replacements**

NOTE: SUPPORT SPACING

Every attempt has been made to insure locational dimensions of the supports are correct. However, after one line of air distributor anchors for any grid type have been installed, the locations must be checked for proper clearances by installing the supplied air headers. Spacing between lines must be checked for fit with the cross manifold and drain line. Any discrepancies or interferences must be brought to the attention of SANITAIRE prior to further installation.

The actual support anchor locations must be indexed from the centerline of the manifold. The actual accumulative dimensional error from the manifold to the anchor bolt must not exceed $\pm 3/4"$.

NOTE:
 This sheet shows the existing 1301 diffuser holders in Aeration Basin #4, Grid 2 of which 1200 existing holders have diffuser elements installed and 101 "blank" diffusers.
 Contractor to install NEW diffuser elements in only 816 of the 1200 existing holders with old diffuser elements and make the remaining 384 holders "blank" diffusers (in addition to the existing "blank" diffusers).
 Please see the key for locations of new diffuser elements and new "blank" diffusers.

*subject to manufactures final recommendations


GRID TYPE '2'

2	-TANK(S)
1	-GRID(S) PER TANK
27	-AIR DISTRIBUTORS PER GRID
VARIABLES	-DIFFUSER HOLDERS PER AIR DISTRIBUTOR
1301	-TOTAL DIFFUSER HOLDERS PER GRID
VARIABLES	-DIFFUSER ELEMENTS PER AIR DISTRIBUTOR
1200	-DIFFUSER ELEMENTS INSTALLED PER GRID
2400	-TOTAL DIFFUSER ELEMENTS INSTALLED FOR THIS GRID TYPE
101	-TOTAL BLANK DIFFUSERS PER GRID

4			
3			
2			
1			
NO.	DATE	REVISION	BY

TULSA, OK
 NORTHSIDE WWTP


**WPC 23-3
 214.1C**

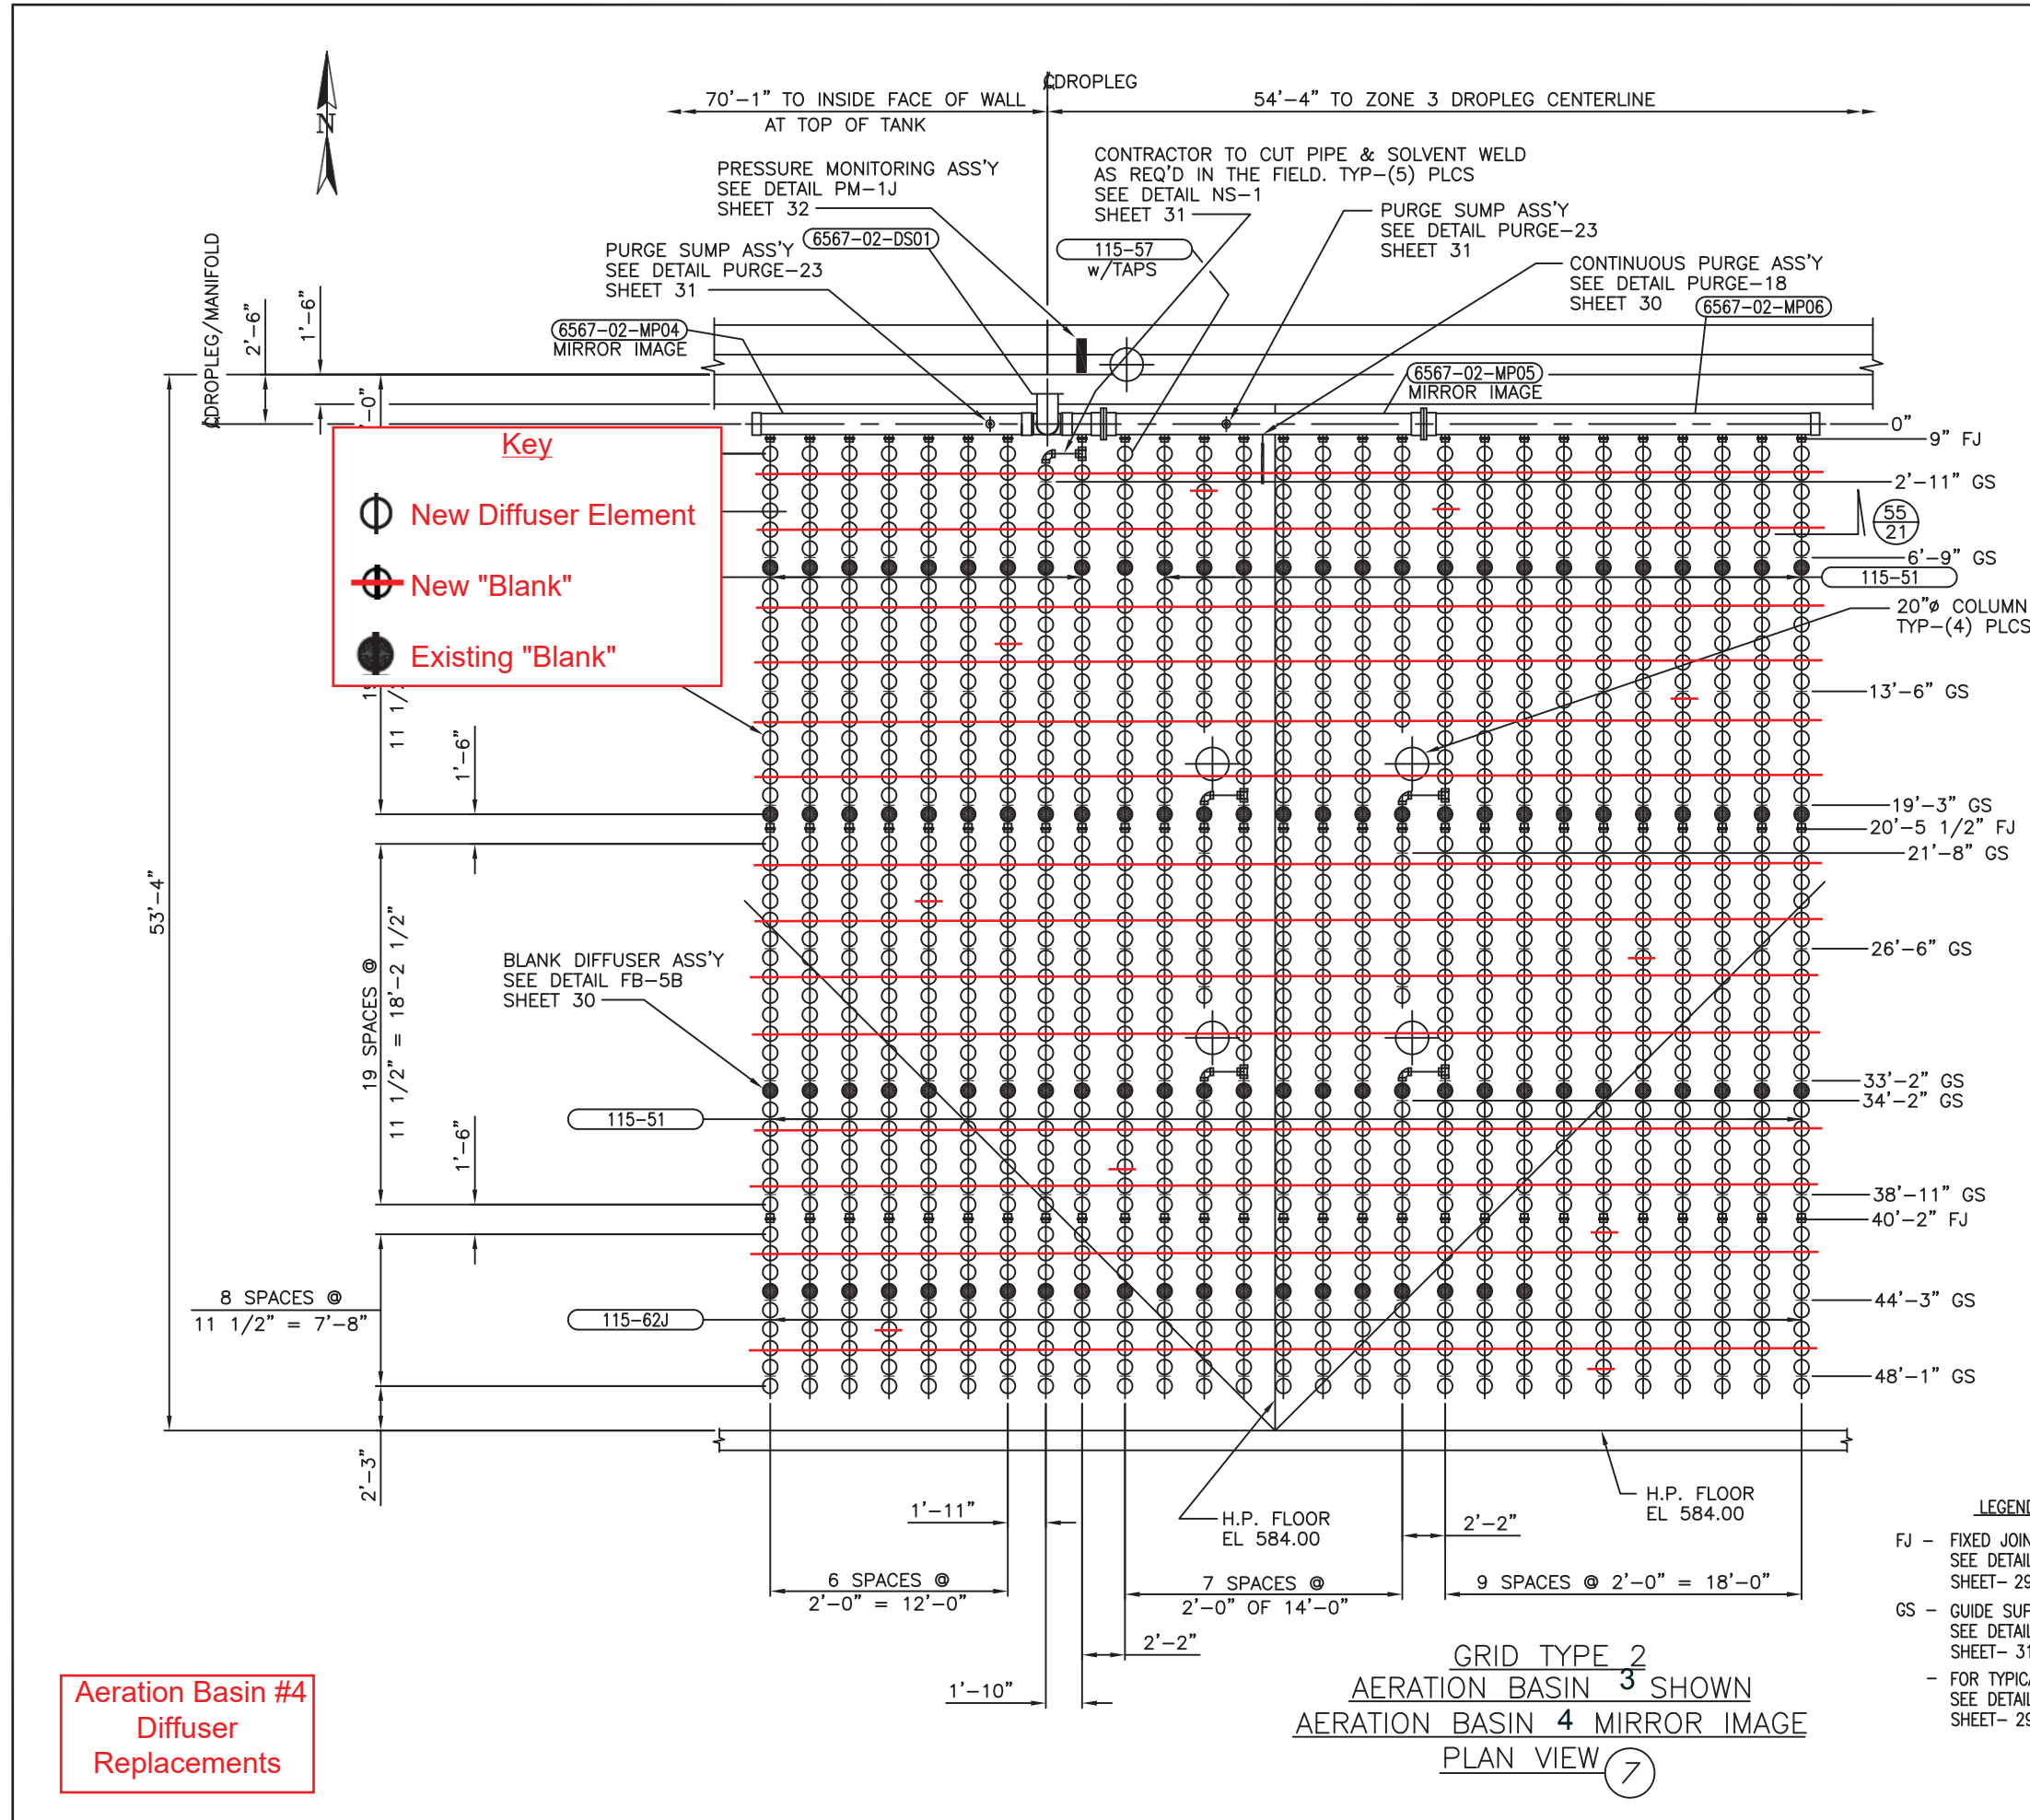

**Aeration Basin #4
 Diffuser
 Replacements**

**GRID TYPE 2
 AERATION BASIN 3 SHOWN
 AERATION BASIN 4 MIRROR IMAGE
 PLAN VIEW**

Notes:
 Remove & Replace ring diffusers and visually inspect all plugged units intended to be plugged. Replace missing plugs as necessary.

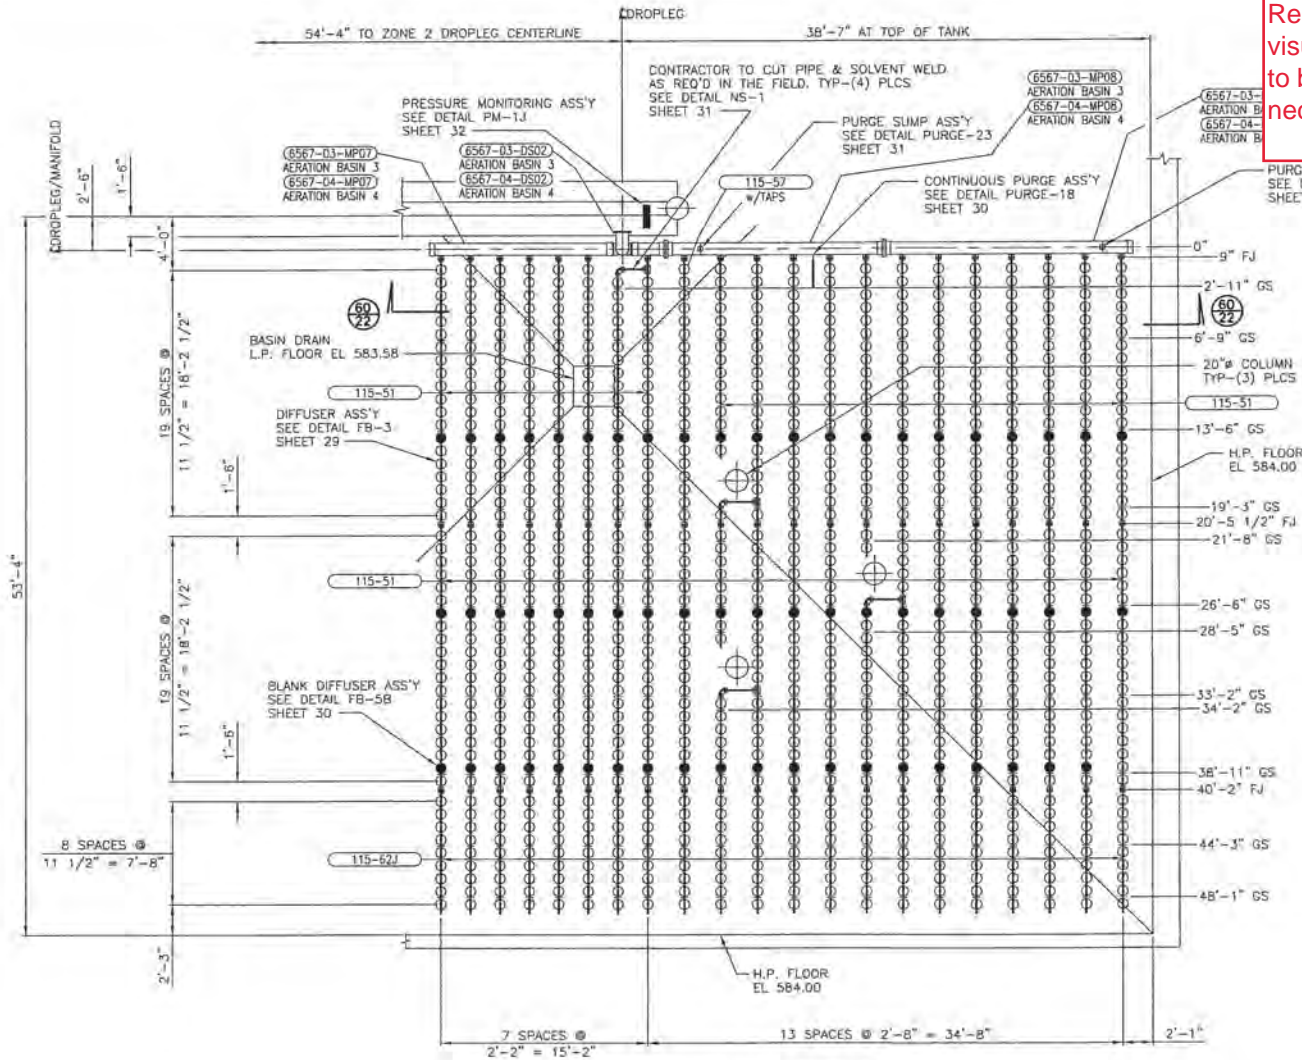

NOTE: SUPPORT SPACING
 Every attempt has been made to insure locational dimensions of the supports are correct. However, after one line of air distributor anchors for any grid type has been installed, the locations must be checked for proper clearances by installing the supplied air headers. Spacing between lines must be checked for fit with the cross manifold and drain line. Any discrepancies or interferences must be brought to the attention of SANITAIRE prior to further installation.

The actual support anchor locations must be indexed from the centerline of the manifold. The actual accumulative dimensional error from the manifold to the anchor bolt must not exceed ± 3/4".


- GRID TYPE '3'**
- 2 - TANK(S)
 - 1 - GRID(S) PER TANK
 - 21 - AIR DISTRIBUTORS PER GRID
 - VARIES - DIFFUSER HOLDERS PER AIR DISTRIBUTOR
 - 1012 - TOTAL DIFFUSER HOLDERS PER GRID
 - VARIES - DIFFUSER ELEMENTS PER AIR DISTRIBUTOR
 - 950 - DIFFUSER ELEMENTS INSTALLED PER GRID
 - 1900 - TOTAL DIFFUSER ELEMENTS INSTALLED FOR THIS GRID TYPE
 - 62 - TOTAL BLANK DIFFUSERS PER GRID

4			
1			
1			
1			
NO.	DATE	REVISION	BY

**WPC 23-3
 214.1D**

**GRID TYPE 3
 AERATION BASIN 3 SHOWN
 AERATION BASIN 4 MIRROR IMAGE
 PLAN VIEW (29)**

Notes:
 Remove & Replace ring diffusers and visually inspect all plugged units intended to be plugged. Replace missing plugs as necessary.

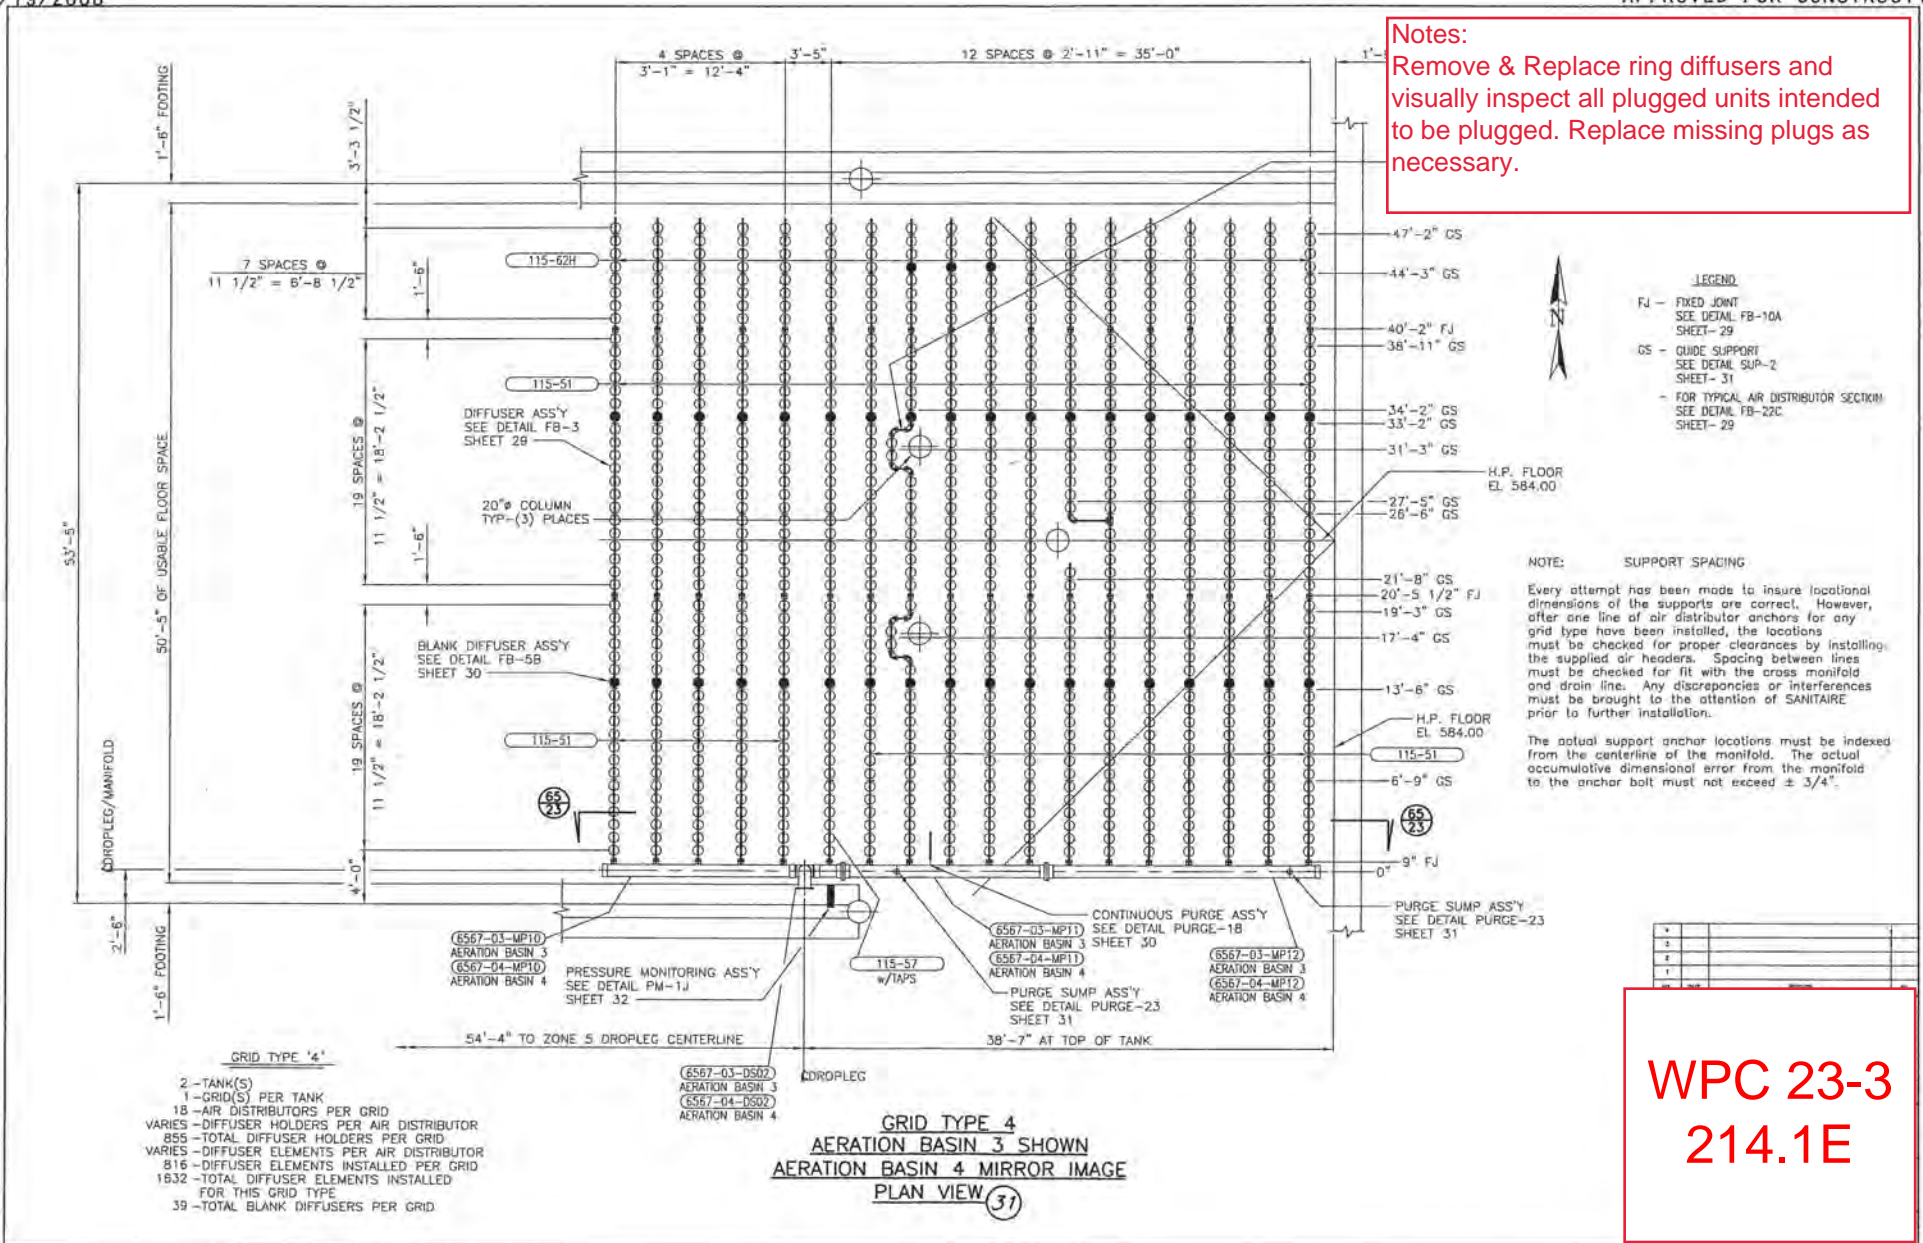

LEGEND

- FJ - FIXED JOINT SEE DETAIL FB-10A SHEET - 29
- GS - GUIDE SUPPORT SEE DETAIL SUP-2 SHEET - 31
- FOR TYPICAL AIR DISTRIBUTOR SECTION SEE DETAIL FB-22C SHEET - 29

NOTE: SUPPORT SPACING

Every attempt has been made to insure locational dimensions of the supports are correct. However, after one line of air distributor anchors for any grid type have been installed, the locations must be checked for proper clearances by installing the supplied air headers. Spacing between lines must be checked for fit with the cross manifold and drain line. Any discrepancies or interferences must be brought to the attention of SANITAIRE prior to further installation.

The actual support anchor locations must be indexed from the centerline of the manifold. The actual accumulative dimensional error from the manifold to the anchor bolt must not exceed $\pm 3/4"$.

1	
2	
3	
4	
5	

**WPC 23-3
 214.1E**

**GRID TYPE 4
 AERATION BASIN 3 SHOWN
 AERATION BASIN 4 MIRROR IMAGE
 PLAN VIEW (37)**

- 2 - TANK(S)
- 1 - GRID(S) PER TANK
- 18 - AIR DISTRIBUTORS PER GRID
- VARIABLES - DIFFUSER HOLDERS PER AIR DISTRIBUTOR
- 855 - TOTAL DIFFUSER HOLDERS PER GRID
- VARIABLES - DIFFUSER ELEMENTS PER AIR DISTRIBUTOR
- 816 - DIFFUSER ELEMENTS INSTALLED PER GRID
- 1832 - TOTAL DIFFUSER ELEMENTS INSTALLED FOR THIS GRID TYPE
- 39 - TOTAL BLANK DIFFUSERS PER GRID


(6567-03-DS02)
 AERATION BASIN 3
 (6567-04-DS02)
 AERATION BASIN 4

(6567-05-MP11)
 AERATION BASIN 3 SHEET 30
 (6567-04-MP11)
 AERATION BASIN 4
 PURGE SUMP ASS'Y
 SEE DETAIL PURGE-23
 SHEET 31

(6567-03-MP12)
 AERATION BASIN 3
 (6567-04-MP12)
 AERATION BASIN 4

(6567-03-MP10)
 AERATION BASIN 3
 (6567-04-MP10)
 AERATION BASIN 4
 PRESSURE MONITORING ASS'Y
 SEE DETAIL PM-1J
 SHEET 32

Notes:
 Remove & Replace ring diffusers and visually inspect all plugged units. Replace plug as necessary

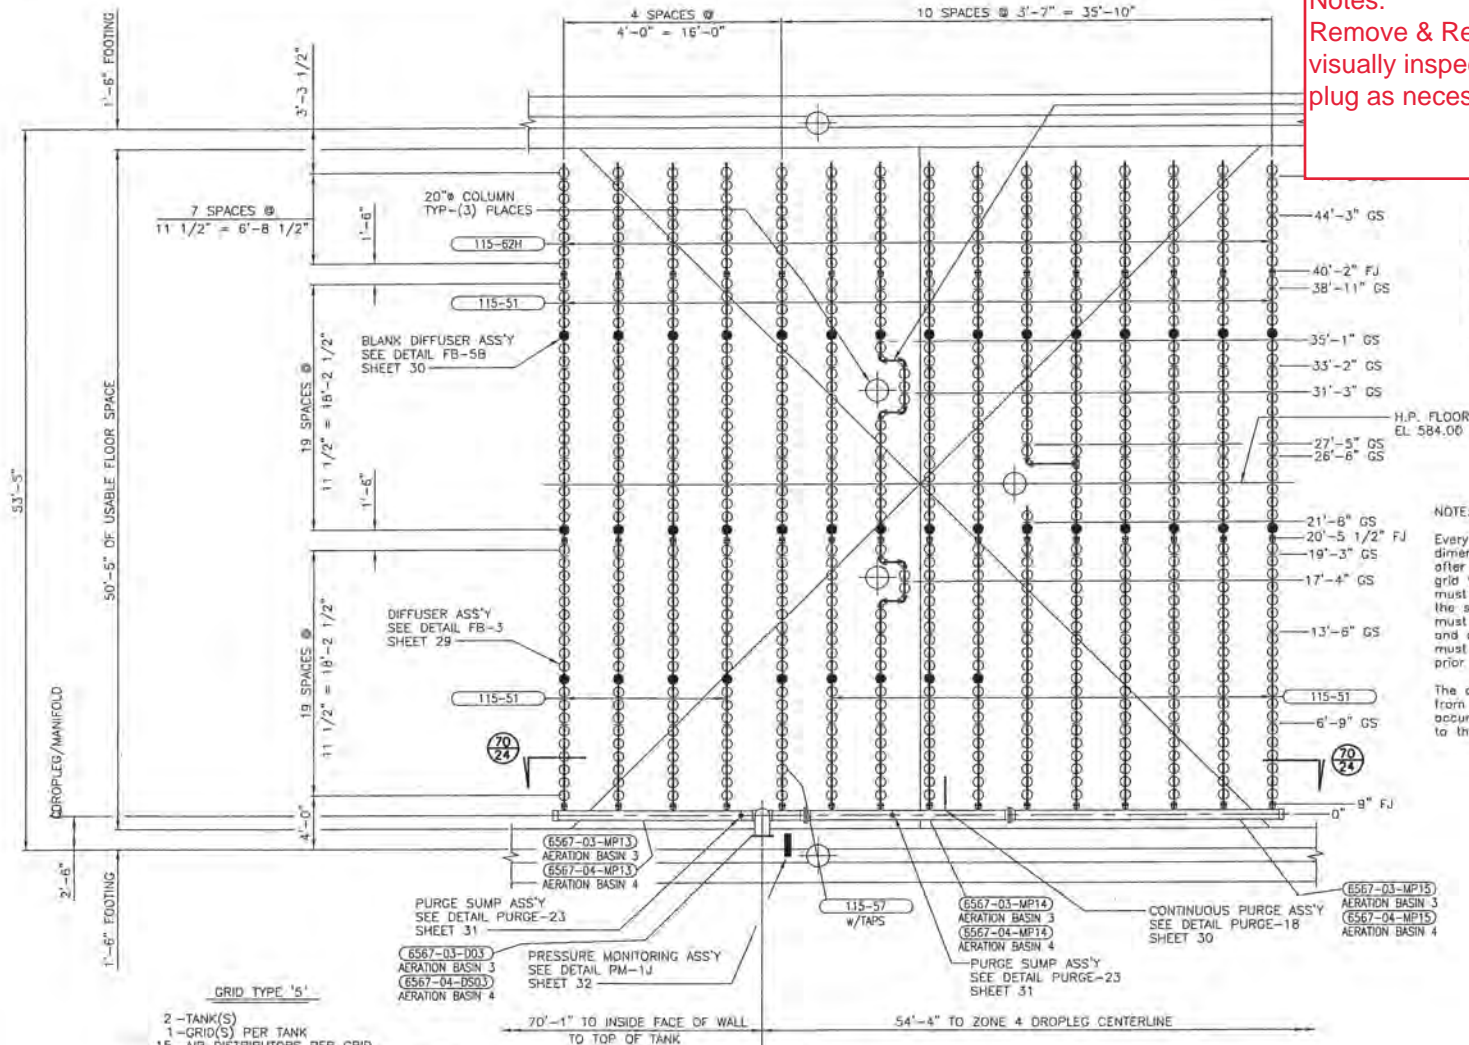

- LEGEND**
- FJ - FIXED JOINT
SEE DETAIL FB-10A
SHEET-29
 - GS - GUIDE SUPPORT
SEE DETAIL SUP-2
SHEET-31
 - FOR TYPICAL AIR DISTRIBUTOR SECTION
SEE DETAIL FB-22C
SHEET-29

NOTE: SUPPORT SPACING

Every attempt has been made to insure locational dimensions of the supports are correct. However, after one line of air distributor anchors for any grid type have been installed, the locations must be checked for proper clearances by installing the supplied air headers. Spacing between lines must be checked for fit with the cross manifold and drain line. Any discrepancies or interferences must be brought to the attention of SANITAIRE prior to further installation.

The actual support anchor locations must be indexed from the centerline of the manifold. The actual accumulative dimensional error from the manifold to the anchor bolt must not exceed ± 3/4".


NO.	REV.	DESCRIPTION	BY

- GRID TYPE '5'**
- 2 -TANK(S)
 - 1 -GRID(S) PER TANK
 - 15 -AIR DISTRIBUTORS PER GRID
 - VARIES -DIFFUSER HOLDERS PER AIR DISTRIBUTOR
 - 711 -TOTAL DIFFUSER HOLDERS PER GRID
 - VARIES -DIFFUSER ELEMENTS PER AIR DISTRIBUTOR
 - 672 -DIFFUSER ELEMENTS INSTALLED PER GRID
 - 1344 -TOTAL DIFFUSER ELEMENTS INSTALLED FOR THIS GRID TYPE
 - 39 -TOTAL BLANK DIFFUSERS PER GRID

**GRID TYPE 5
 AERATION BASIN 3 SHOWN
 AERATION BASIN 4 MIRROR IMAGE
 PLAN VIEW 33**

**WPC 23-3
 214.1F**

Notes:
 Remove & Replace ring diffusers and visually inspect all plugged units intended to be plugged. Replace missing plugs as necessary.

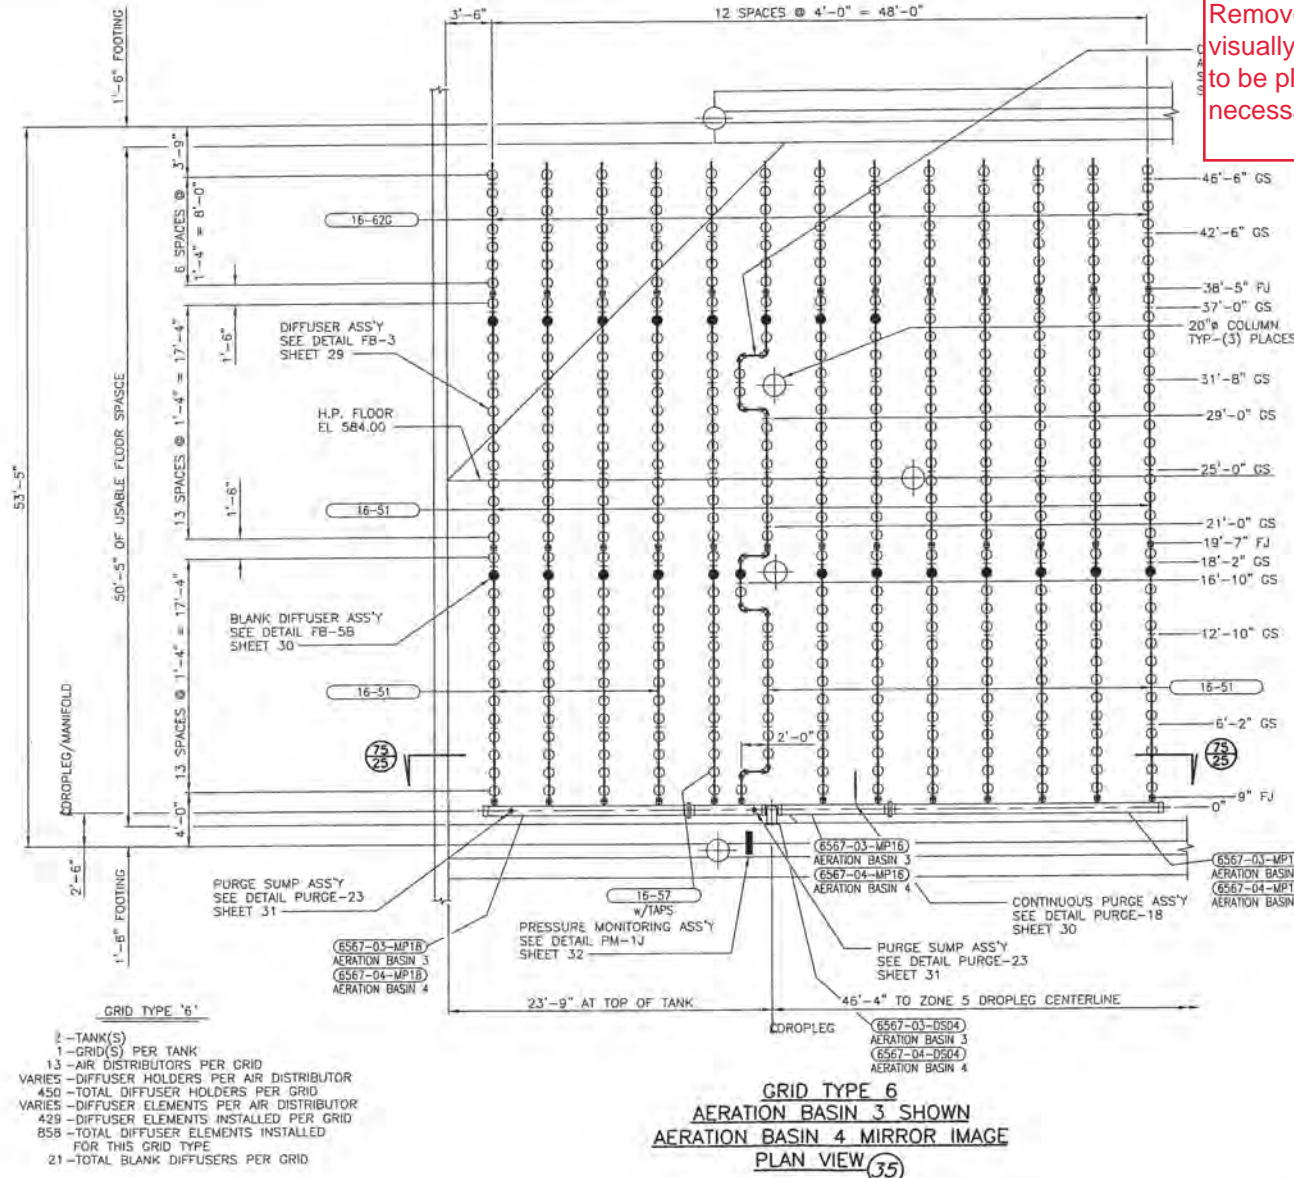

LEGEND

- FJ - FIXED JOINT
SEE DETAIL FB-10A
SHEET- 29
- GS - GUIDE SUPPORT
SEE DETAIL SUP-2
SHEET- 31
- FOR TYPICAL AIR DISTRIBUTOR SECTION
SEE DETAIL FB-22C
SHEET- 29

NOTE: SUPPORT SPACING


Every attempt has been made to insure locational dimensions of the supports are correct. However, after one line of air distributor anchors for any grid type have been installed, the locations must be checked for proper clearances by installing the supplied air headers. Spacing between lines must be checked for fit with the cross manifold and drain line. Any discrepancies or interferences must be brought to the attention of SANITAIRE prior to further installation.

The actual support anchor locations must be indexed from the centerline of the manifold. The actual accumulative dimensional error from the manifold to the anchor bolt must not exceed $\pm 3/4"$.

4			
3			
2			
1			
DL	REV	DATE	BY

WPC 23-3
214.1G

Notes:
 Remove & Replace ring diffusers and visually inspect all plugged units intended to be plugged. Replace missing plugs as necessary.

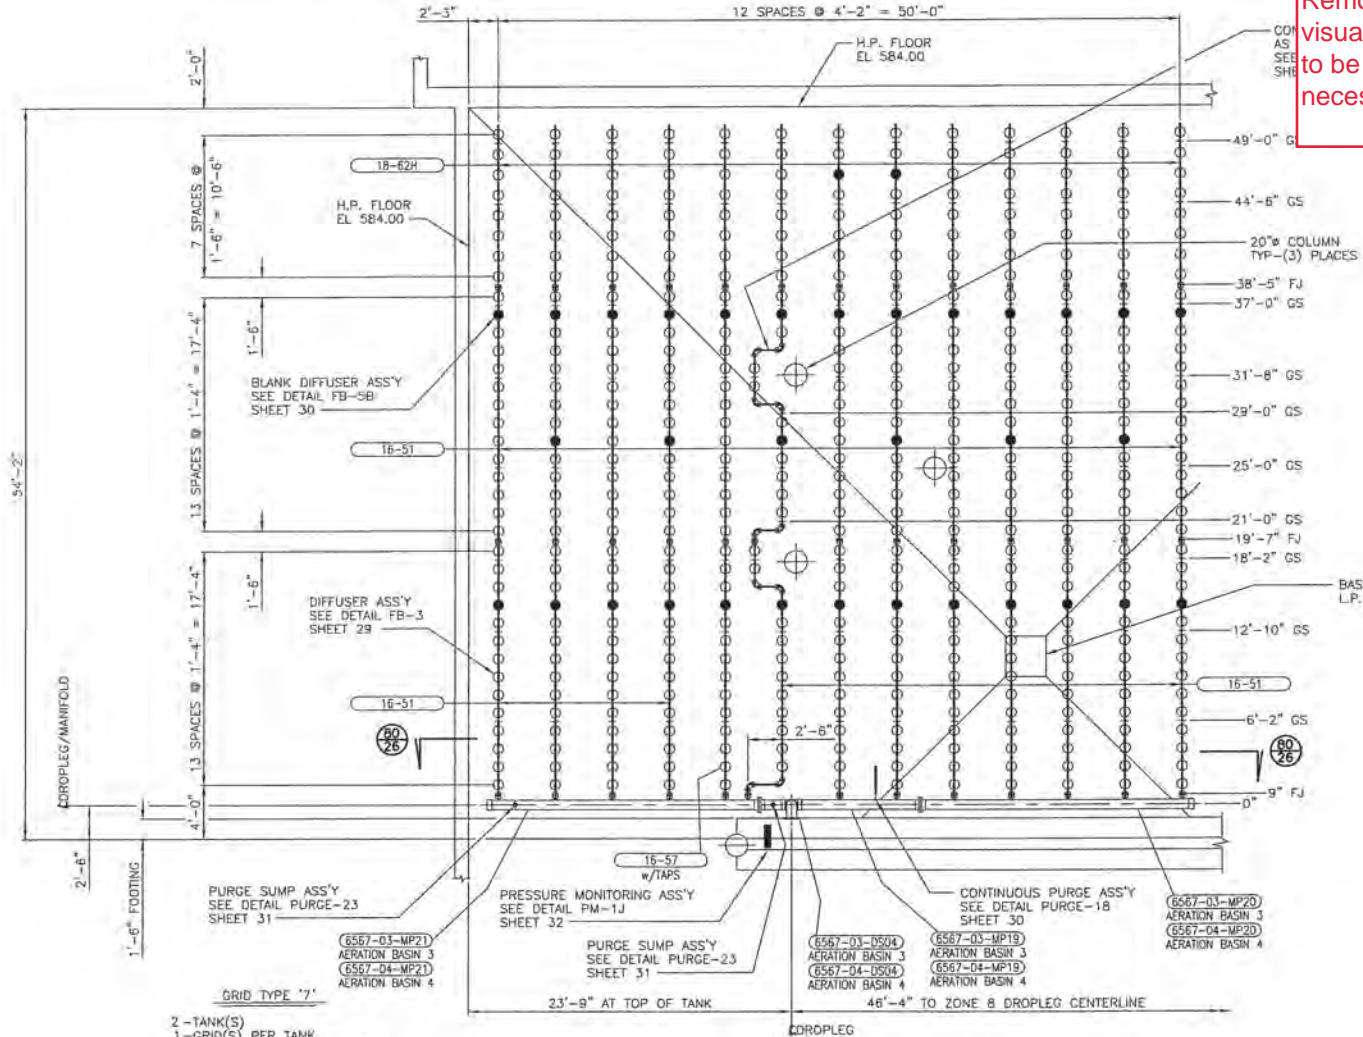

NOTE: SUPPORT SPACING

Every attempt has been made to insure locational dimensions of the supports are correct. However, after one line of air distributor anchors for any grid type have been installed, the locations must be checked for proper clearances by installing the supplied air headers. Spacing between lines must be checked for fit with the cross manifold and drain line. Any discrepancies or interferences must be brought to the attention of SANITAIRE prior to further installation.

The actual support anchor locations must be indexed from the centerline of the manifold. The actual accumulative dimensional error from the manifold to the anchor bolt must not exceed ± 3/4".

LEGEND

FJ - FIXED JOINT
 SEE DETAIL FB-10A
 SHEET-29

GS - GUIDE SUPPORT
 SEE DETAIL SUP-2
 SHEET-31

- FOR TYPICAL AIR DISTRIBUTOR SECTION
 SEE DETAIL FB-22C
 SHEET-29

4			
3			
2			
1			
1			
NO.	DATE	REVISION	BY

- GRID TYPE '7'**
- 2 - TANK(S)
 - 1 - GRID(S) PER TANK
 - 13 - AIR DISTRIBUTORS PER GRID
 - VARIES - DIFFUSER HOLDERS PER AIR DISTRIBUTOR
 - 463 - TOTAL DIFFUSER HOLDERS PER GRID
 - VARIES - DIFFUSER ELEMENTS PER AIR DISTRIBUTOR
 - 429 - DIFFUSER ELEMENTS INSTALLED PER GRID
 - 858 - TOTAL DIFFUSER ELEMENTS INSTALLED FOR THIS GRID TYPE
 - 34 - TOTAL BLANK DIFFUSERS PER GRID

**GRID TYPE 7
 AERATION BASIN 3 SHOWN
 AERATION BASIN 4 MIRROR IMAGE
 PLAN VIEW 37**

**WPC 23-3
 214.1H**

Notes:
 Remove & Replace ring diffusers and visually inspect all plugged units intended to be plugged. Replace missing plugs as necessary.

LEGEND

- FJ - FIXED JOINT
SEE DETAIL FB-10A
SHEET - 29
- GS - GUIDE SUPPORT
SEE DETAIL SUP-2
SHEET - 31
- FOR TYPICAL AIR DISTRIBUTOR SECTION
SEE DETAIL FB-22C
SHEET - 29


NOTE: SUPPORT SPACING

Every attempt has been made to insure locational dimensions of the supports are correct. However, after one line of air distributor anchors for any grid type have been installed, the locations must be checked for proper clearances by installing the supplied air headers. Spacing between lines must be checked for fit with the cross manifold and drain line. Any discrepancies or interferences must be brought to the attention of SANITAIRE prior to further installation.

The actual support anchor locations must be indexed from the centerline of the manifold. The actual accumulative dimensional error from the manifold to the anchor bolt must not exceed $\pm 3/4"$.

4			
3			
2			
1			
0			


WPC 23-3
214.11

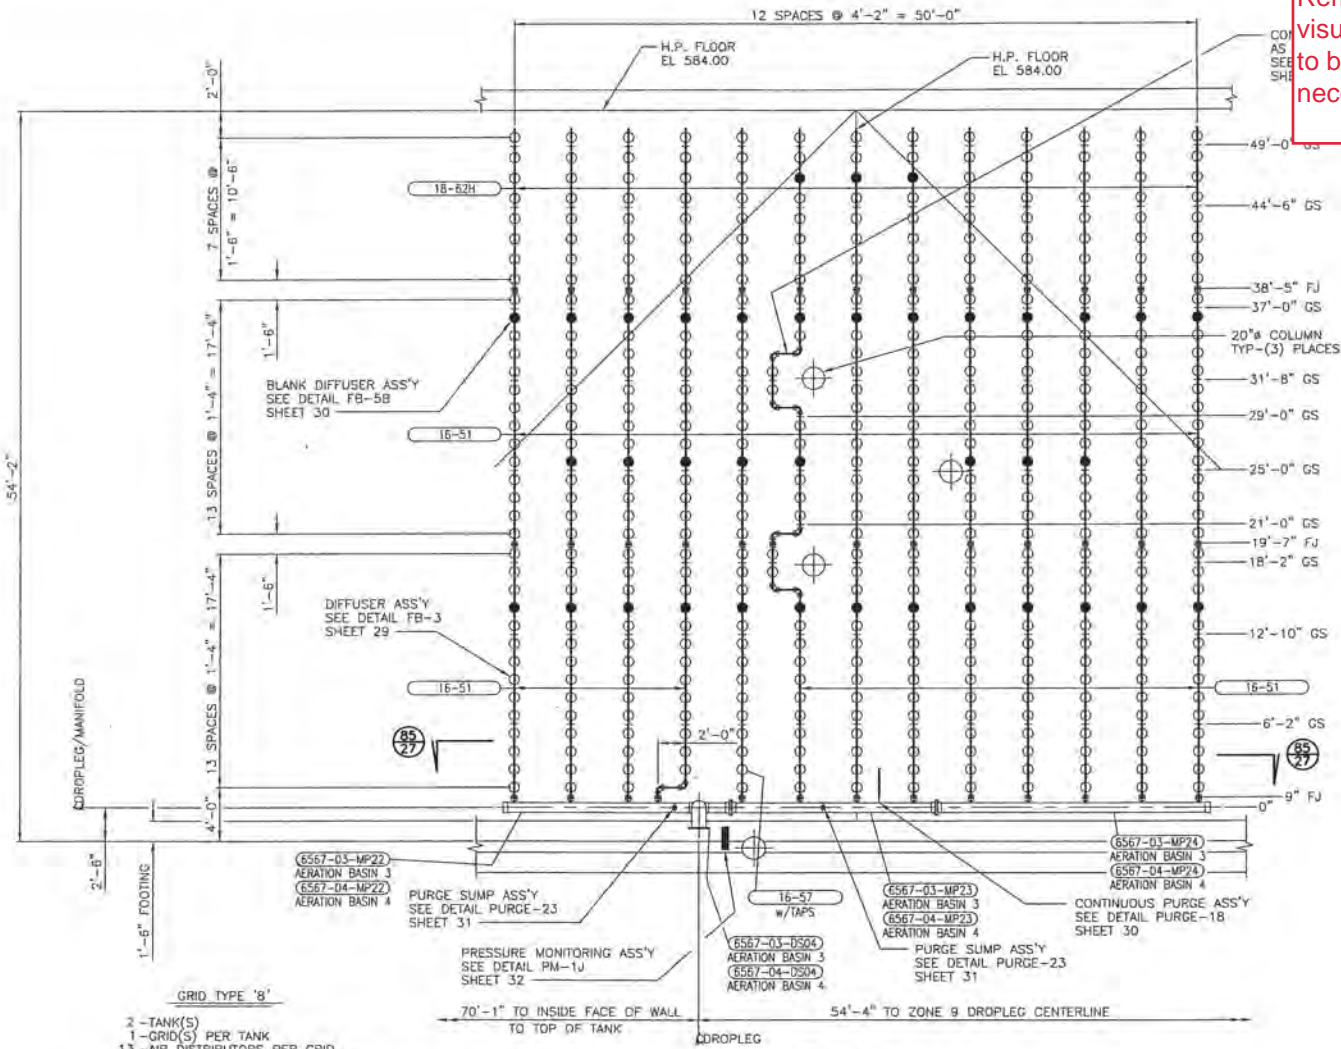

- GRID TYPE 'B'**
- 2 - TANK(S)
 - 1 - GRID(S) PER TANK
 - 13 - AIR DISTRIBUTORS PER GRID
 - VARIES - DIFFUSER HOLDERS PER AIR DISTRIBUTOR
 - 463 - TOTAL DIFFUSER HOLDERS PER GRID
 - VARIES - DIFFUSER ELEMENTS PER AIR DISTRIBUTOR
 - 429 - DIFFUSER ELEMENTS INSTALLED PER GRID
 - 858 - TOTAL DIFFUSER ELEMENTS INSTALLED FOR THIS GRID TYPE
 - 34 - TOTAL BLANK DIFFUSERS PER GRID

GRID TYPE B
AERATION BASIN 3 SHOWN
AERATION BASIN 4 MIRROR IMAGE
PLAN VIEW 39

Notes:
 Remove & Replace ring diffusers and visually inspect all plugged units intended to be plugged. Replace missing plugs as necessary.

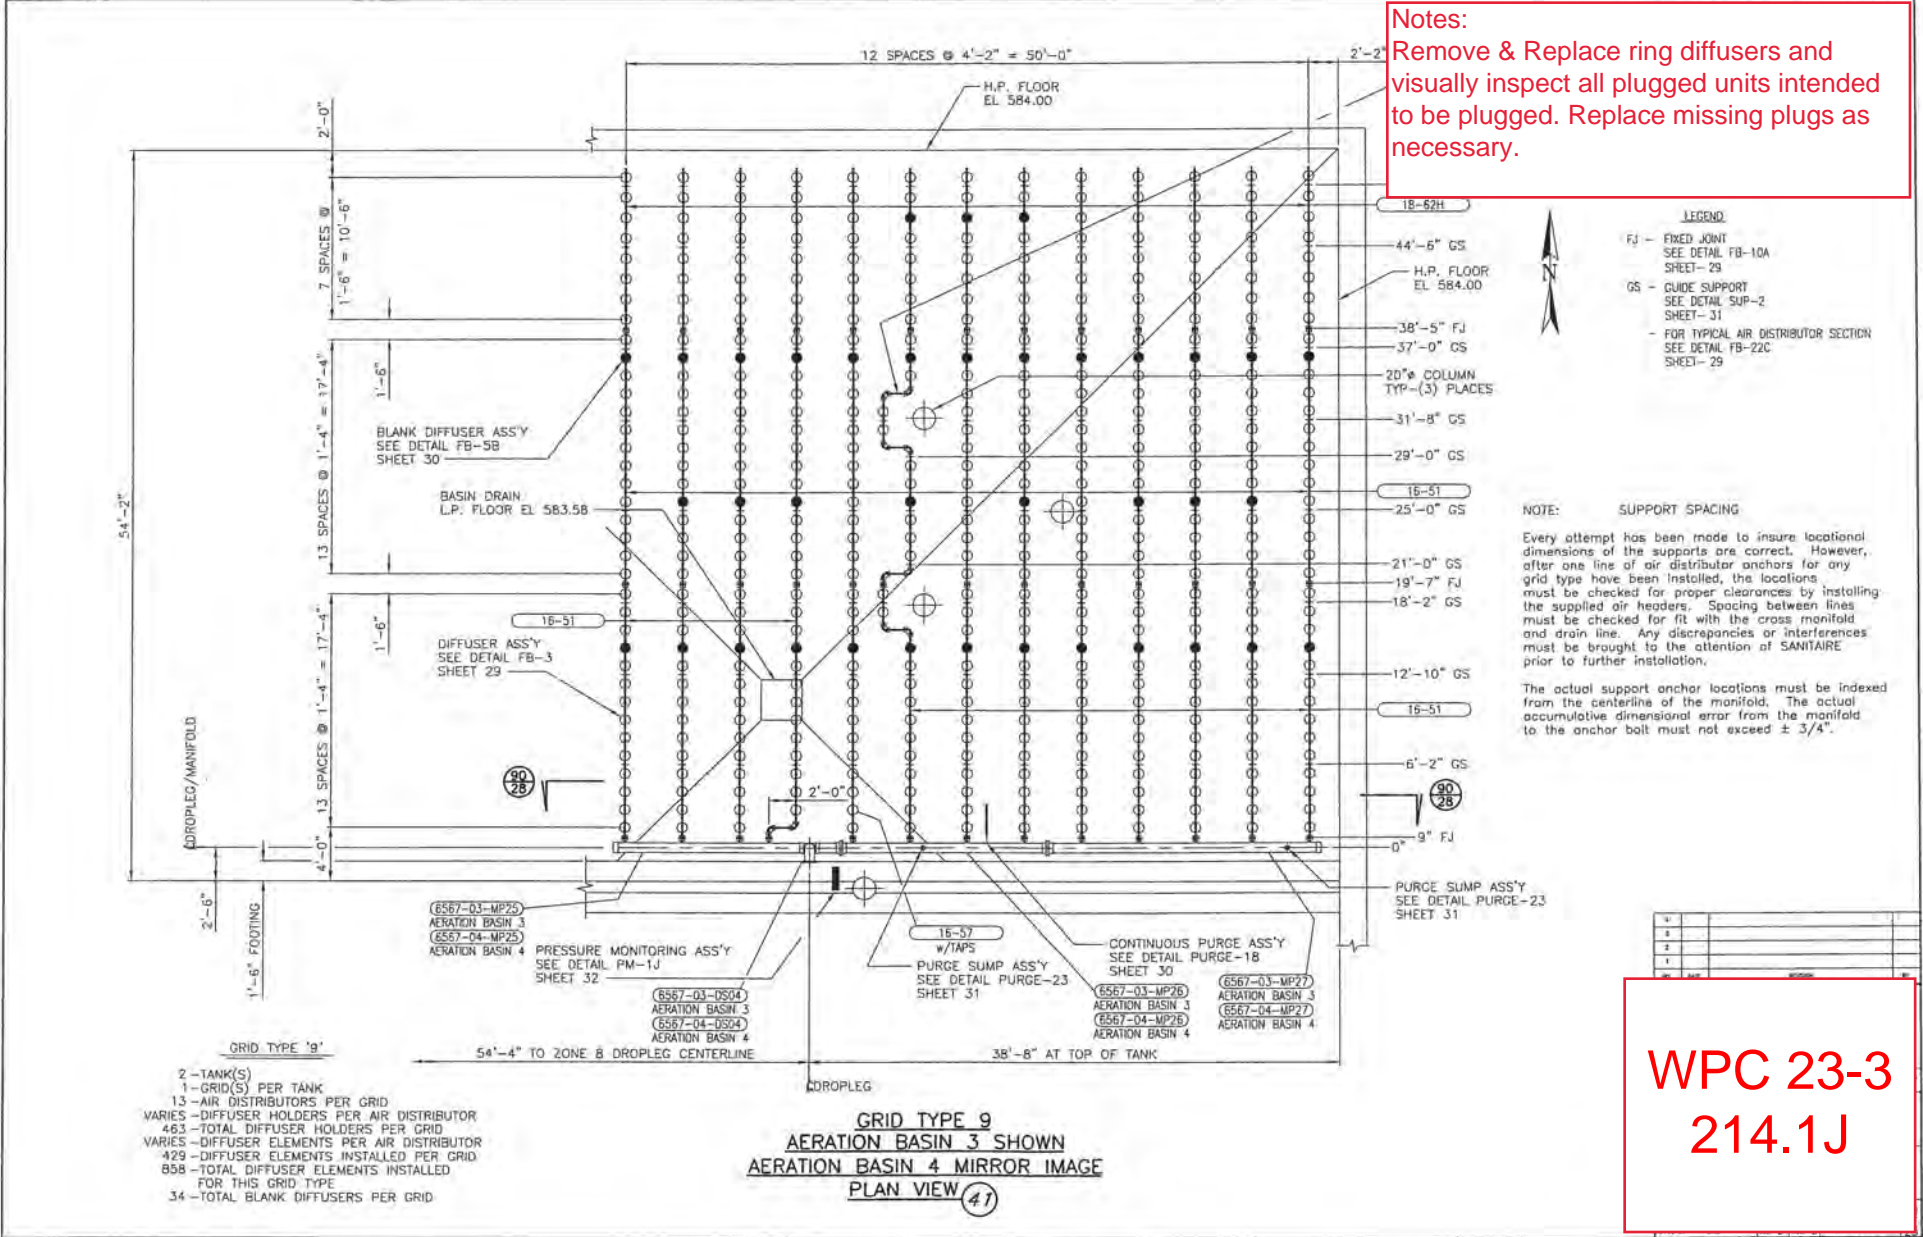


WPC 23-3
214.1J


21	8	1.5TON	SHACKLE-LIFTING		
20	1		SWITCH-LIP		
19	18	.5"	VALVE-BALL		
18	2	.5"	DRAIN-THERMAL PURGE		
17	4		DISCONNECT		
16	4	4.5"	GAUGE-0-160 PSI PRESSURE		DISCH HEADER
15	4	4.5"	GAUGE-30"-0-100 PSI PRESSURE		SUCT HEADER
14	2	1"	VALVE-COMBO AIR RELEASE		
13	4	.5"	VALVE-COMBO AIR RELEASE		
12	16		ISOLATOR-VIBRATION		
11	4		ASSEMBLY-NEMA 1 THERMAL PURGE		
10	4	6"	VALVE-SILENT WAFER CHECK		
9	8	6"	VALVE-AWWA GEAR OPERATED ISO		
8	8	6"	DISMANTLING JOINT-SMITH/BLAIR 975		
7	4	50 HP	PUMP-GOULD'S 92SV31GR4F60 CENTRIFUGAL		
6	1	16"	FLANGE-150# BLIND		
5	1	4"	DISCHARGE-150# FLANGED		
4	1	10"	DISCHARGE-150# FLANGED		
3	1	16"	SUCTION-150# FLANGED		
2	1		SKID		
1	1		SKID		
ITEM	QTY	SIZE	DESCRIPTION	LGTH	PART NO./NOTE

- THIS AREA TO REMAIN CLEAR OF ALL OBSTRUCTIONS, CONDUIT ETC... REQUIRED BY NATIONAL ELECTRIC CODE
- SUCTION AND DISCHARGE PIPING CONNECTIONS MUST BE RESTRAINED AGAINST THRUST BY OTHERS.
- ALL VACANT TOL'S TO BE PLUGGED WITH LIKE MATERIAL PIPE PLUGS
- ALL MANIFOLDS TO BE DETACHABLE.
- PIPING TO BE ASTM A53 B CARBON STEEL FUSION BONDED EPOXY COATED.
- USE ALL LIFTING EYES WHEN LIFTING
- PAINT ANCHOR PLATES SAME COLOR AS SKID
- ALL FLANGES TO BE FLAT FACED
- TRANSMITTER, FLOWMETER AND FLOWMETER PIPING ARE SUPPLIED BY OTHERS
- NOTE HOLD DIMENSIONS


NOTES:
SURFACE PREP & PAINT
 SPEC214.2.6.6 COATINGS SHALL BE PREPPED, BLASTED, CHIP RESISTANT PRIMED, & PAINTED TO MATCH PEW LINE, SHERWIN WILLIAMS OR TNEMEC PANTONE 522 MATCH
 SPEC 214.2.14TAGGING TO CONFORM TO 215.1.4
 *ALL PIPE MARKINGS ARE APPROXIMATE AND MAY NOT BE COMPLETE. CONSULT WITH ENGINEER IF UNCLEAR
 STENCIL FLOW ARROWS & CURRENT PIPE MARKING

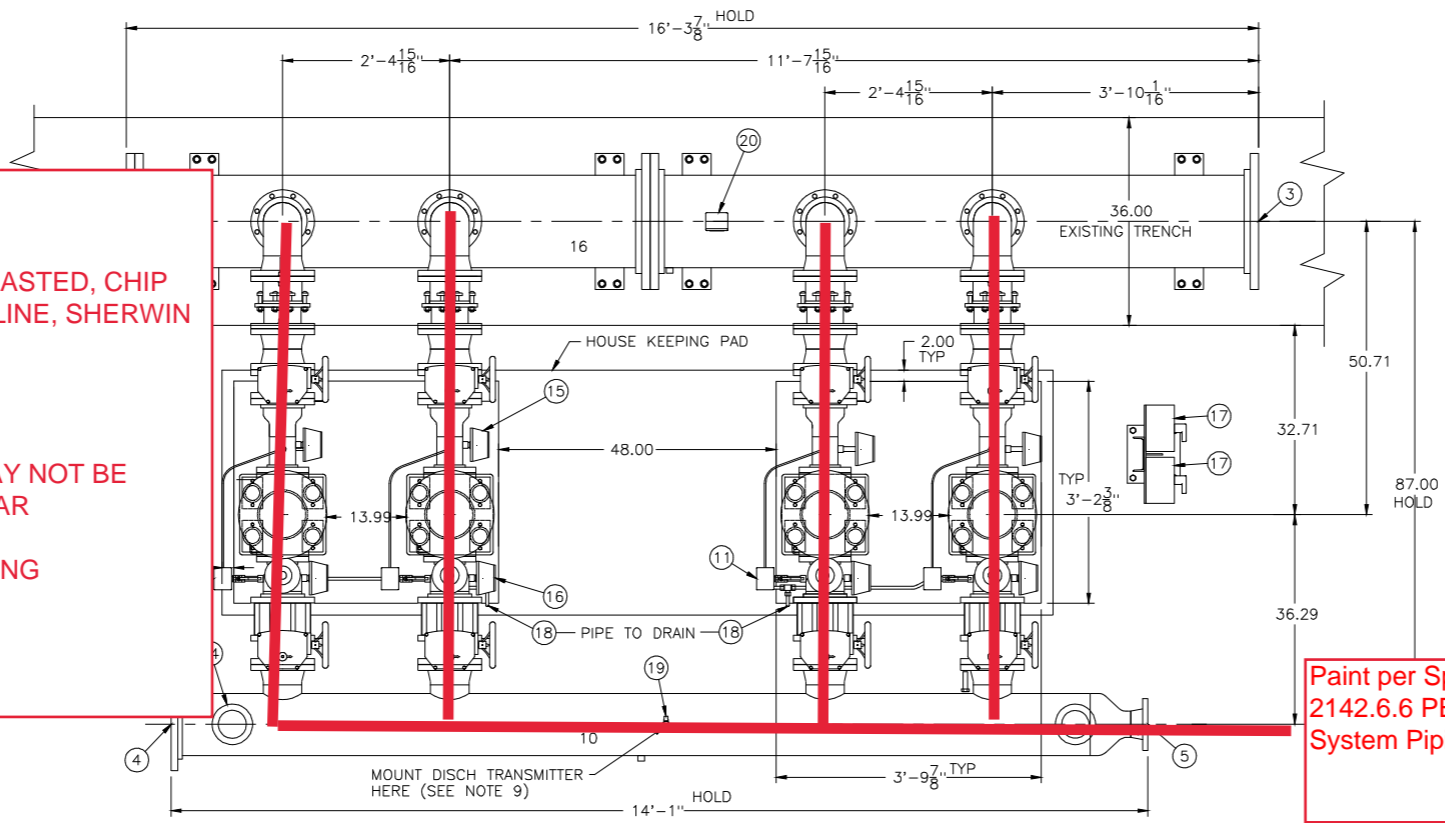


Paint per Spec 2142.6.6 PEW System Piping

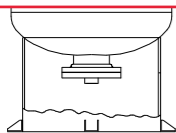


163 ASME TANK SHIP LOOSE

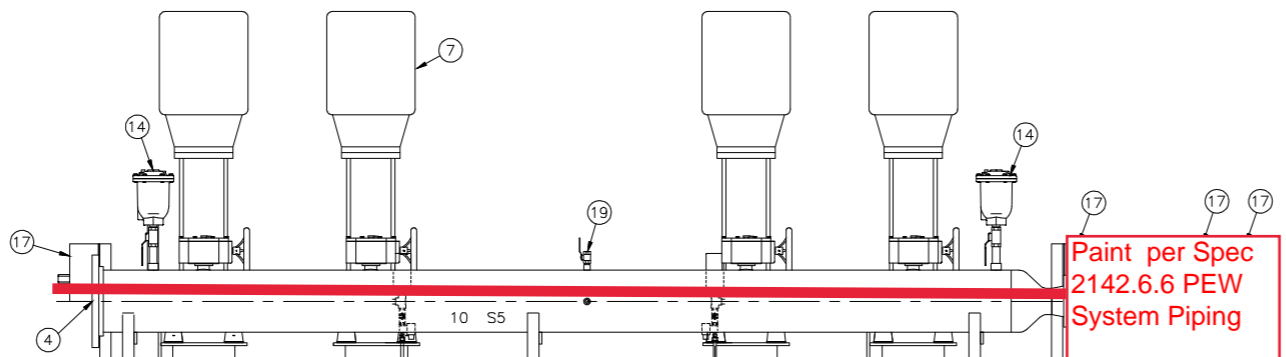

Paint per Spec 2142.6.6 PEW System Piping

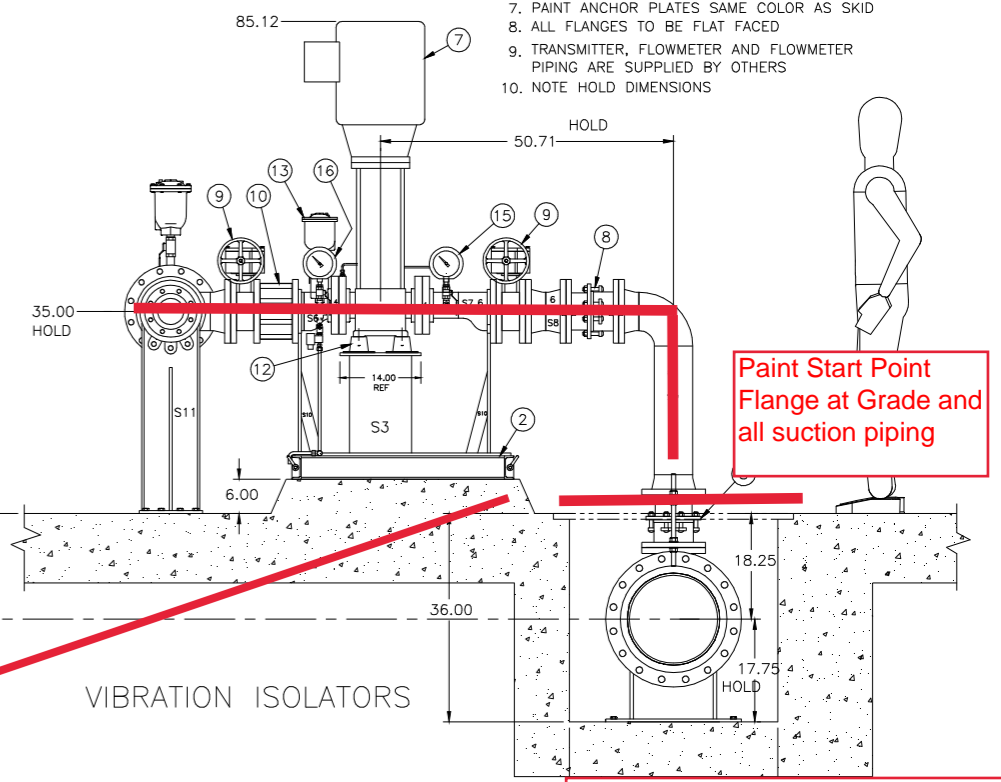

Paint Start Point Flange at Grade and all suction piping



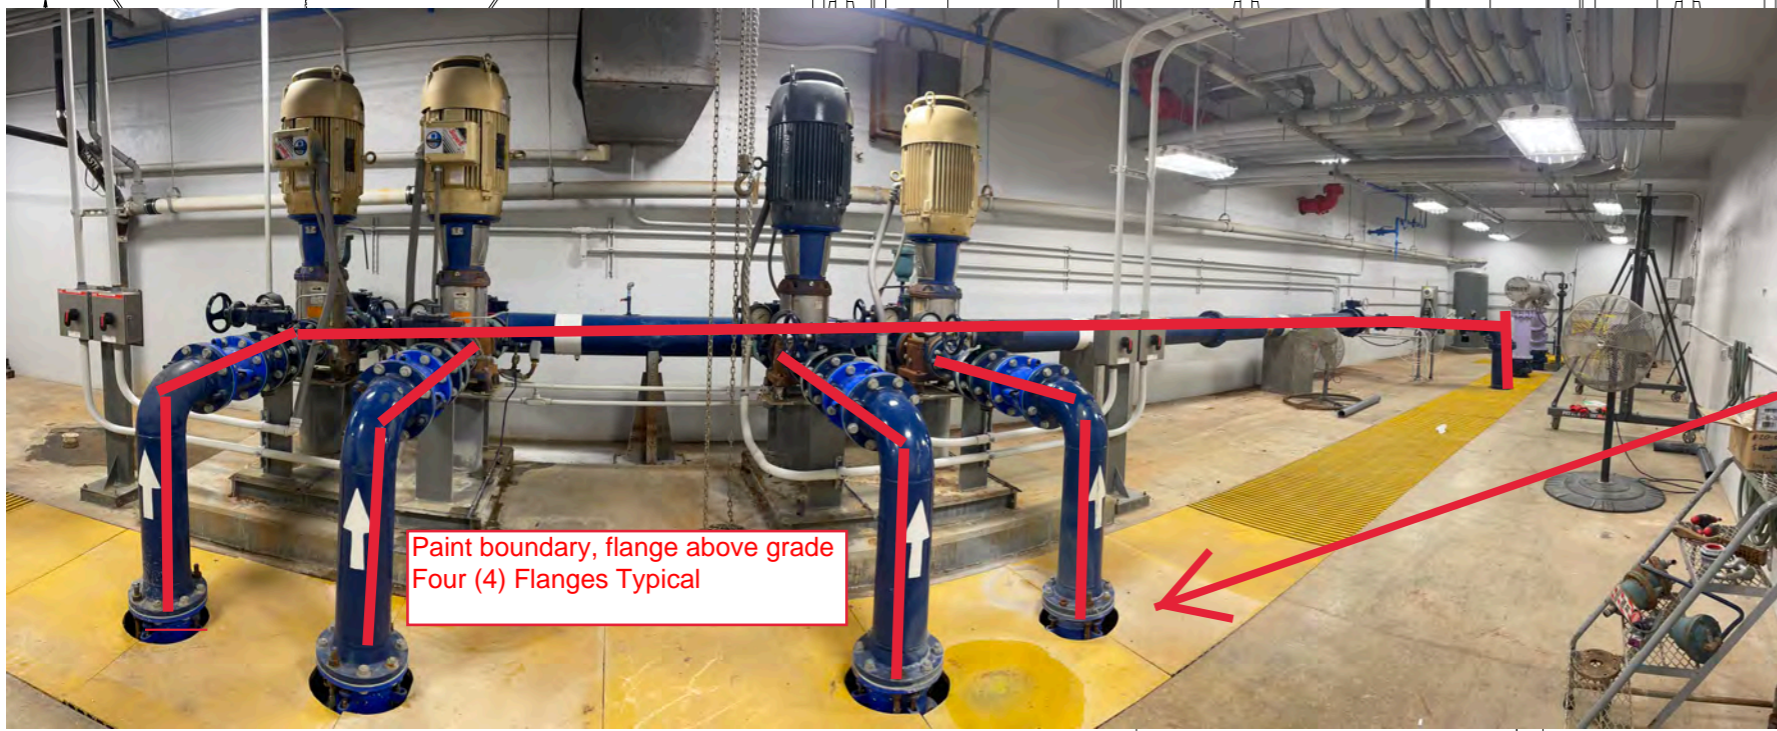


Paint boundary, flange above grade Four (4) Flanges Typical

DATE	BY
11/15/11	JHC
12/21/11	JHC
12/21/11	JHC
12/22/11	JHC
12/22/11	JHC
2/3/12	JHC
3/6/12	JHC
5/11/12	JHC


WPC 23-3
214.2A

10661 DALI
 THIS DRAWING AND THE INFORMATION DEPICTED IS THE PROPERTY OF XYLEM. COPIES ARE STRICT CONFIDENCE AND SHALL NOT BE REPRODUCED, COPIED, OR USED AS THE BASIS FOR THE DESIGN OR SALE OF PRODUCTS WITHOUT PRIOR PERMISSION OF XYLEM.

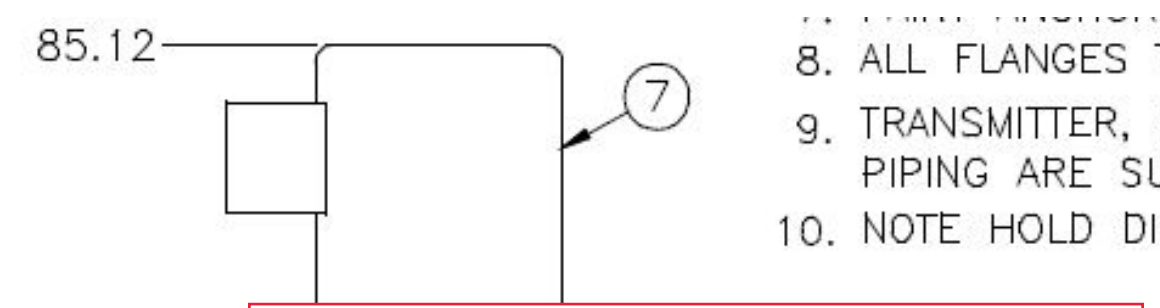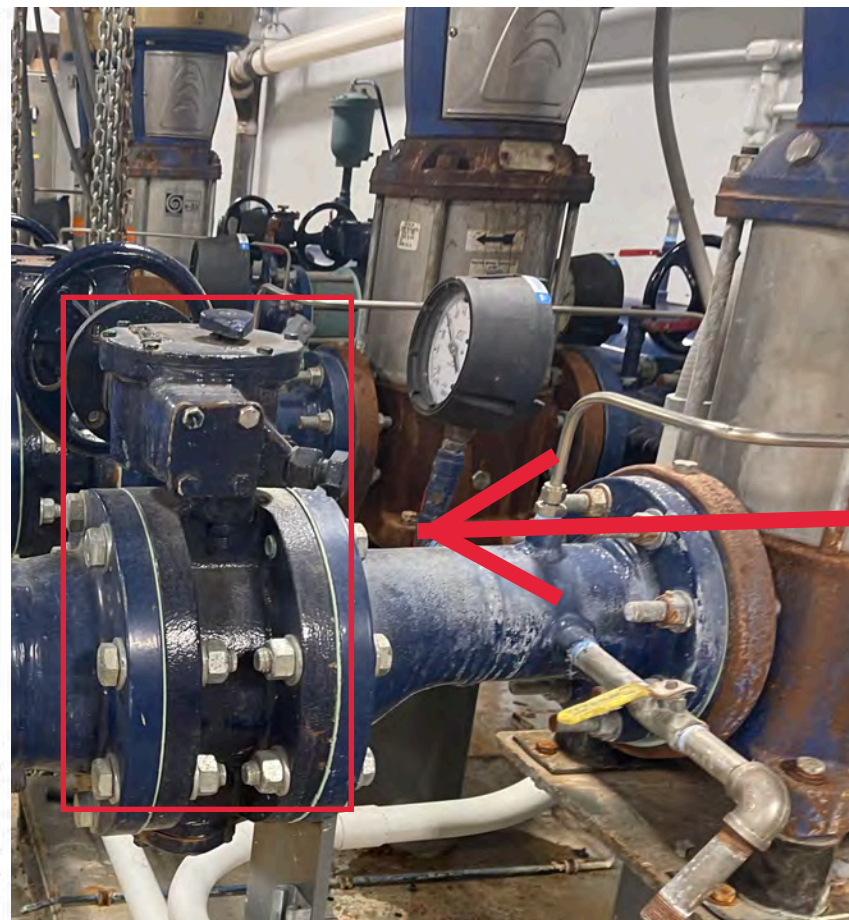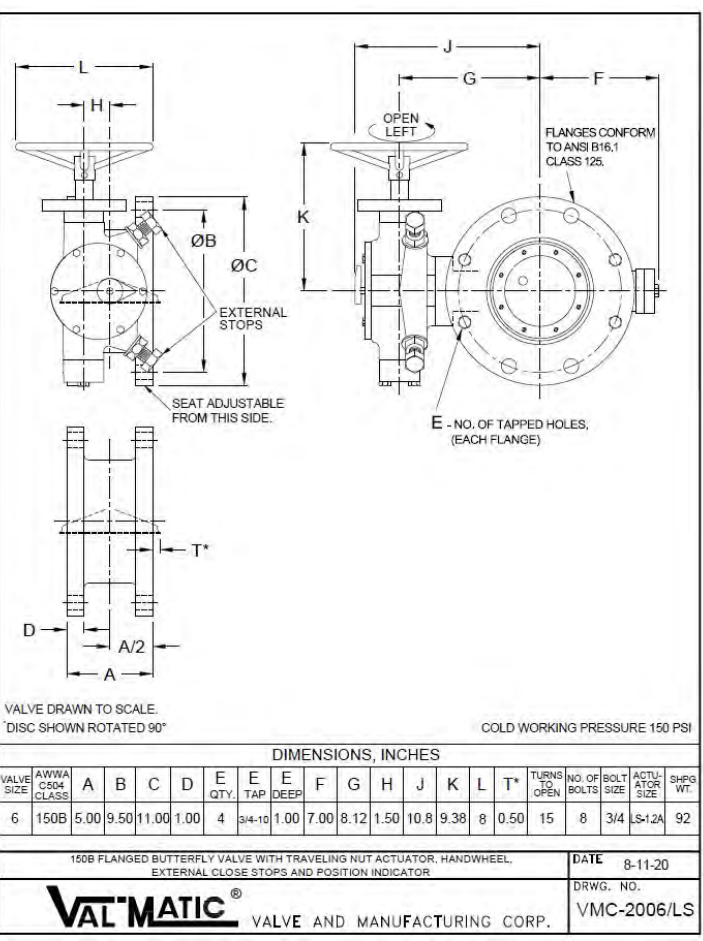

8. ALL FLANGES TO
9. TRANSMITTER, F
PIPING ARE SU
10. NOTE HOLD DIM



Remove & Replace Butterfly four (4) Inlet Valves:
SPEC214.2.6: BUTTERFLY VALVES VAL-MATIC 2006 1B08A OR DEZURIK BAW AWWA
 N060-PEW1-BFV06
 N060-PEW1-BFV07 - ROTATE HANDWHEEL
 N060-PEW1-BFV08
 N060-PEW1-BFV09 - ROTATE HANDWHEEL

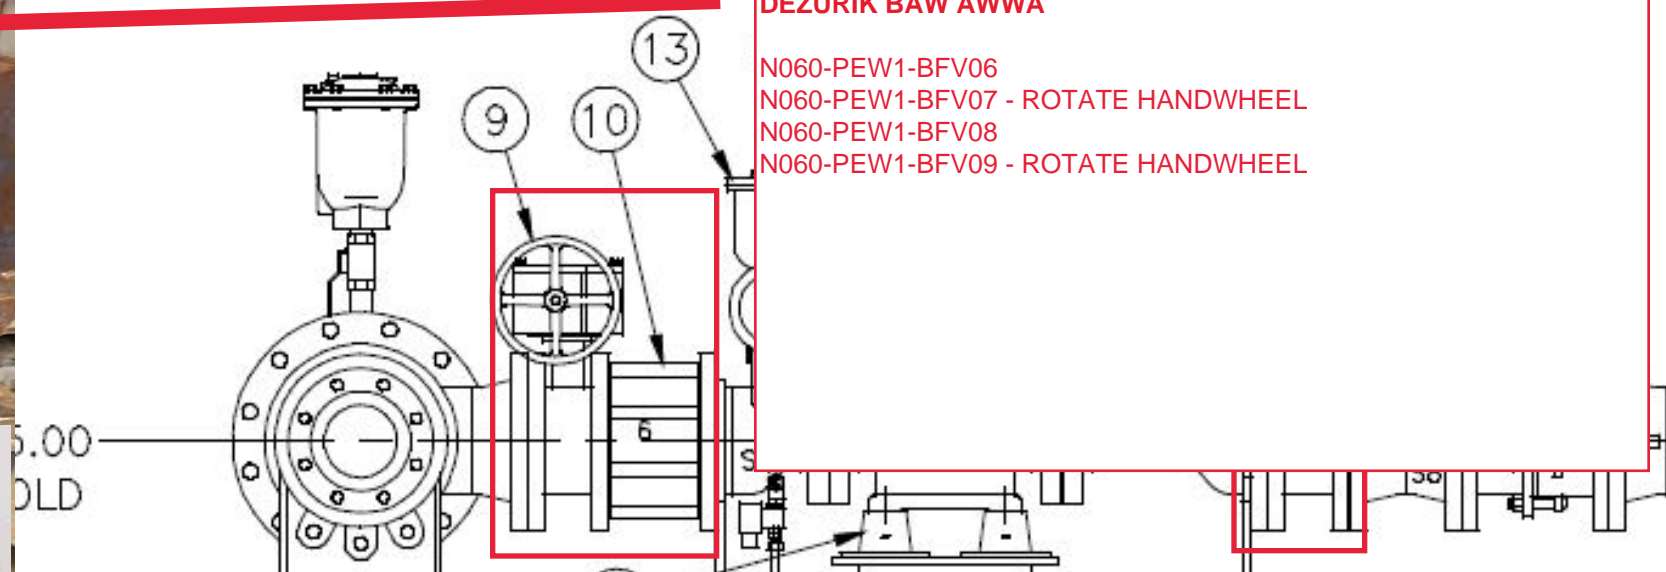


Remove & Replace four (4) Outlet Butterfly & Check valve
Four(4) Typical each valve
SPEC214.2.6: BUTTERFLY VALVES VAL-MATIC 2006 1B08A OR DEZURIK BAW AWWA
SILENT CHECK VALVES TO BE VAL-MATIC1406AH.1 OR DEZURIK CSC SEE VALVE DETAILS FOR DIMENSIONS

Check valves:
 N060-PEW1-CKV01
 N060-PEW1-CKV02
 N060-PEW1-CKV03
 N060-PEW1-CKV04

Butterfly Discharge Valves
 N060-PEW1-BFV10
 N060-PEW1-BFV11 - ROTATE HANDWHEEL
 N060-PEW1-BFV12
 N060-PEW1-BFV13 - ROTATE HANDWHEEL

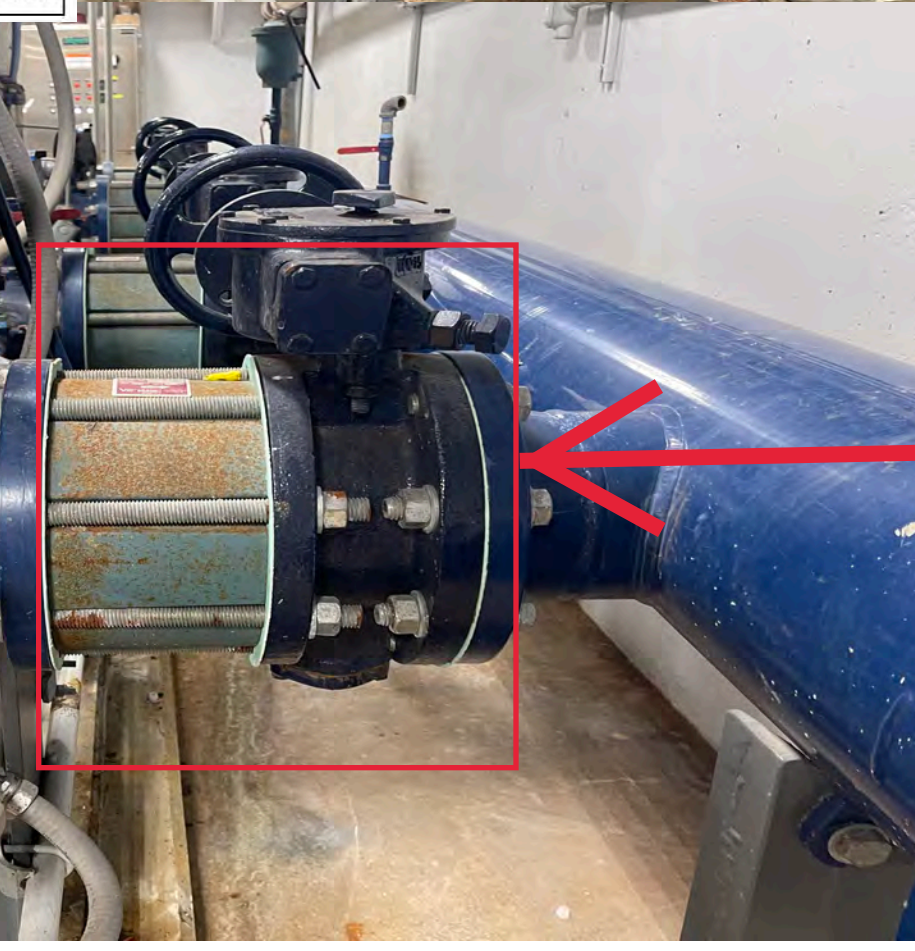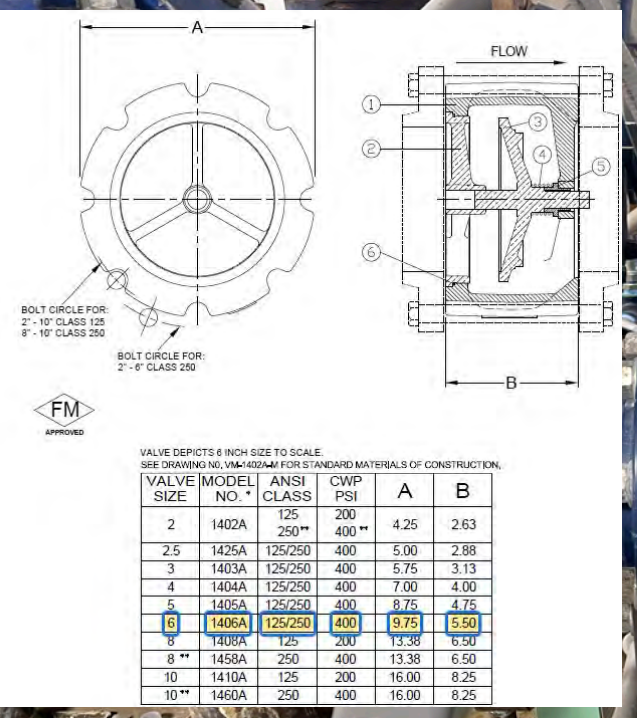

WPC 23-3
214.2B

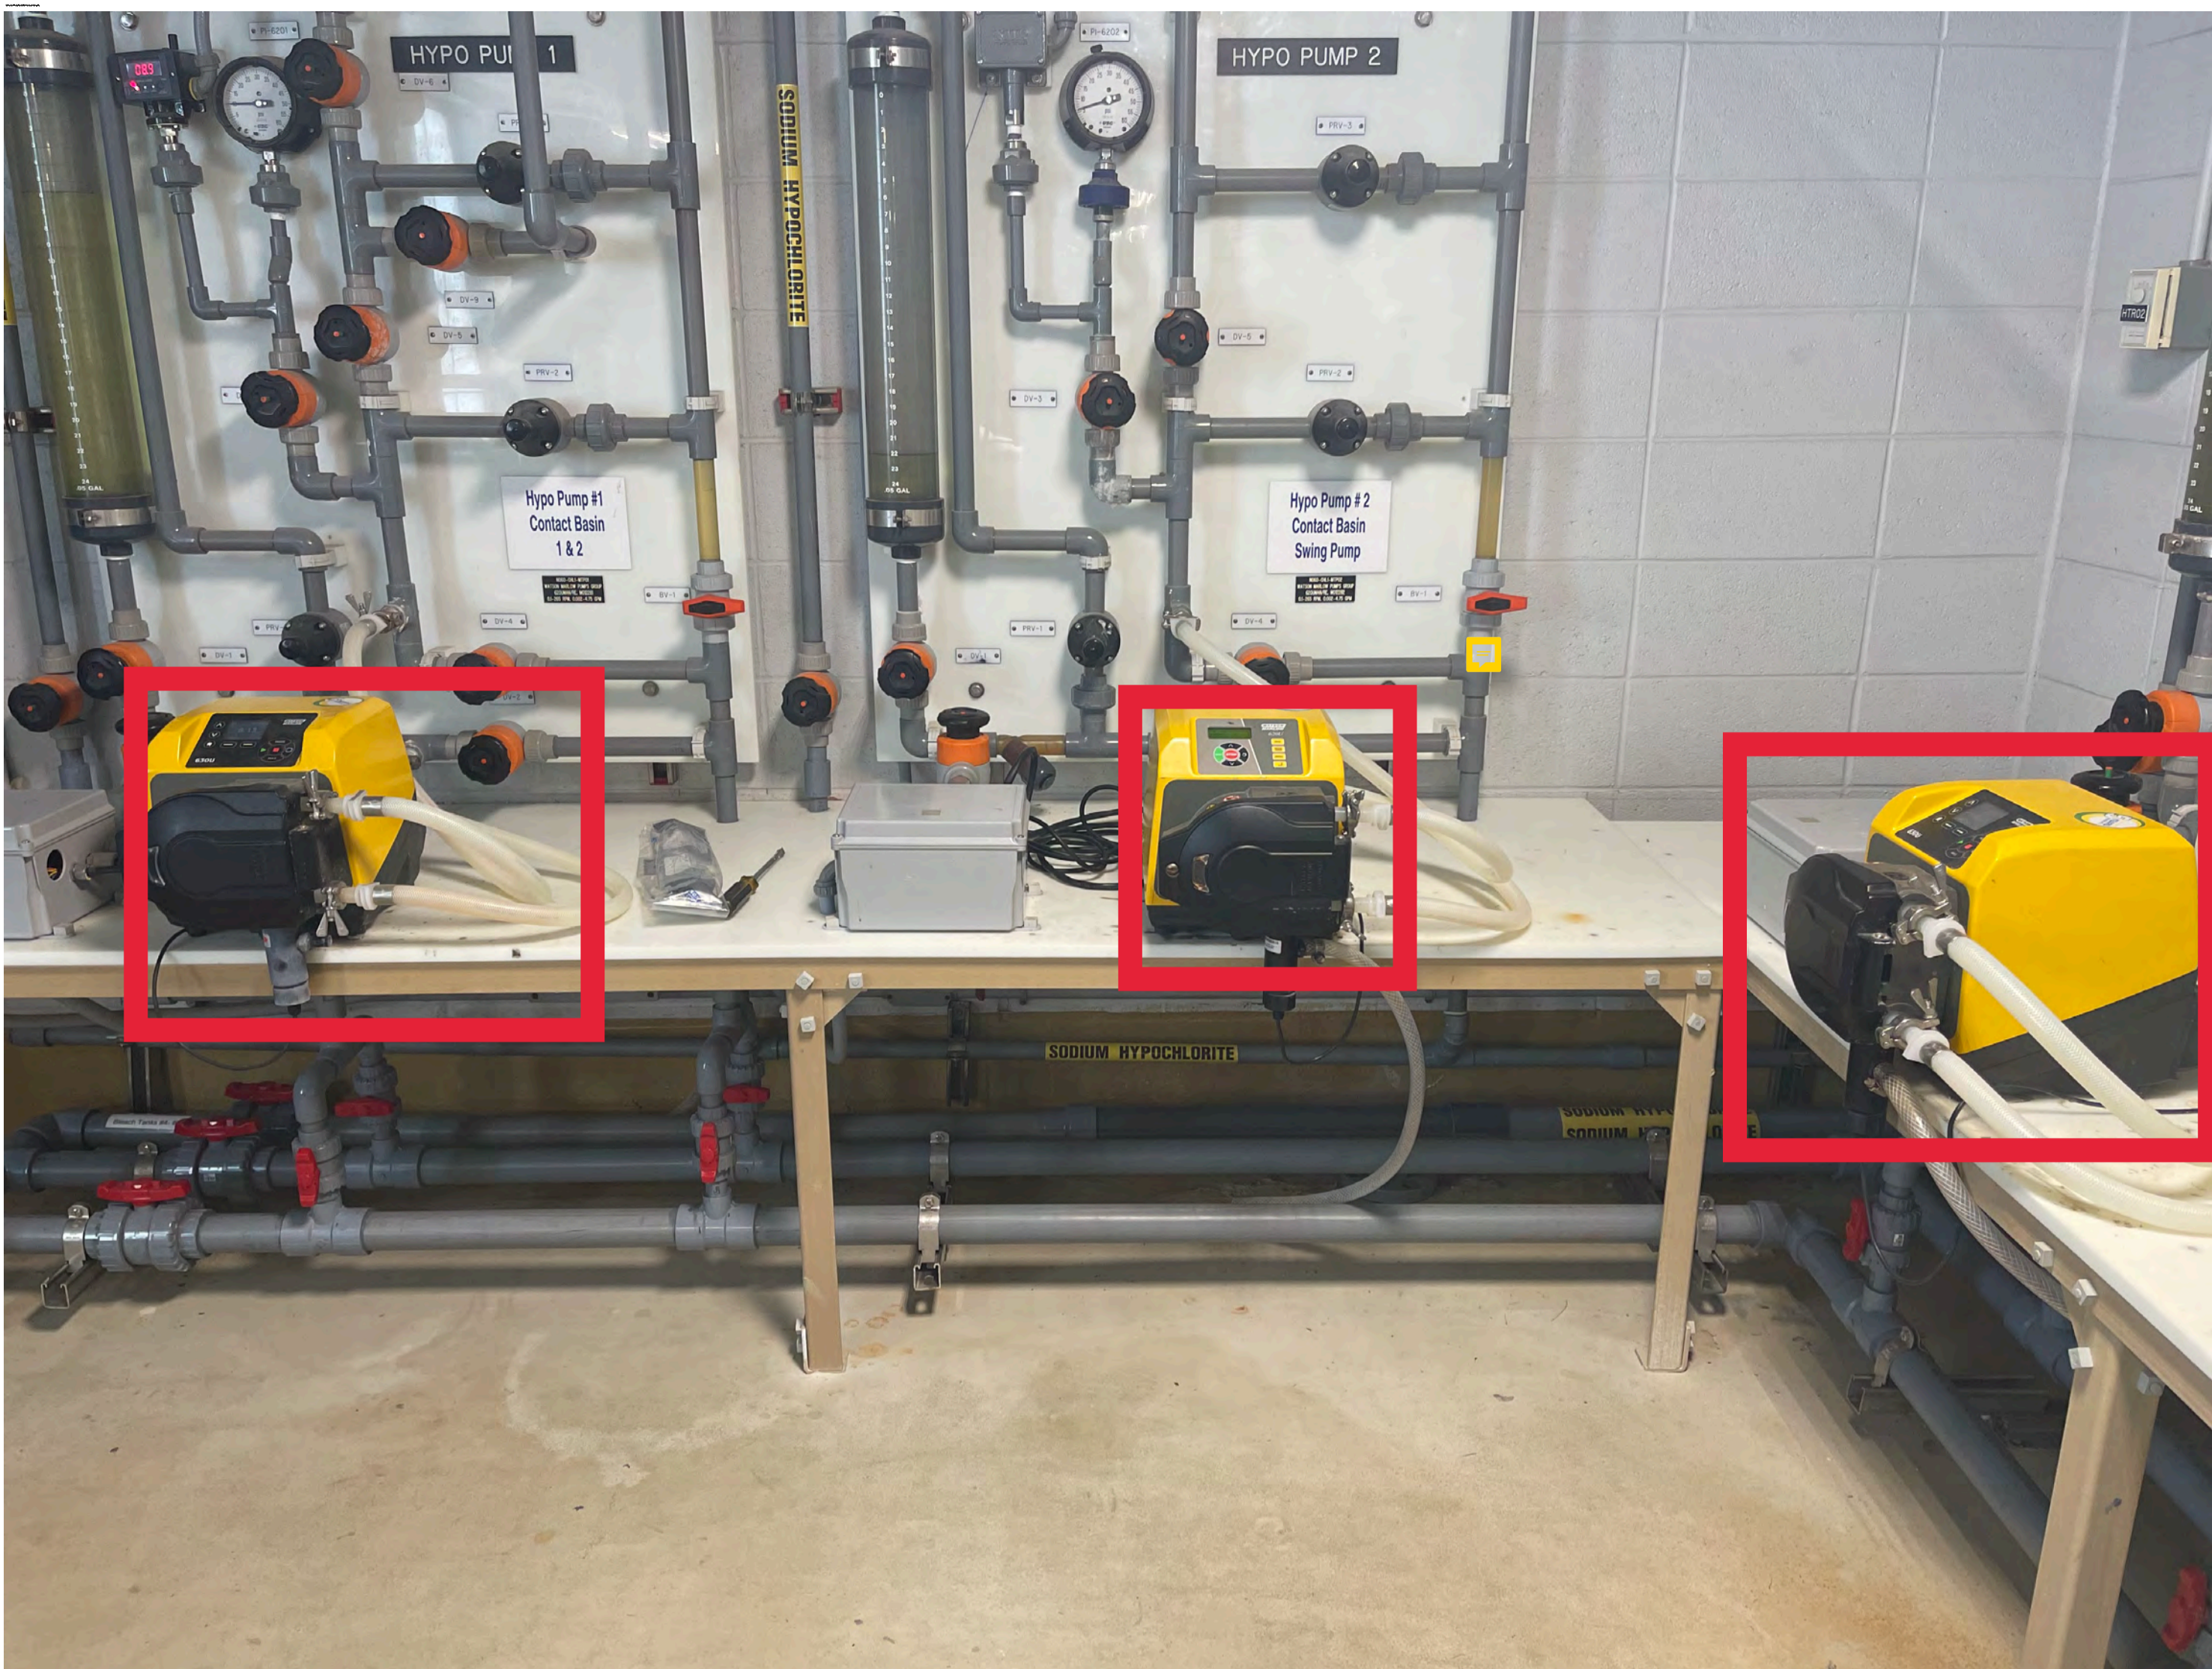


Notes:

Remove & Replace:
 chemical pump # N060-CHL1-MTP01
 chemical pump # N060-CHL1-MTP02
 chemical pump # N060-CHL1-MTP03
 See Spec 214.3.6 Pumps shall be a model 630U Watson Matlow or Blue-White M2s24-QNLR

214.3.6.1. **Conditions of Operation:** Each pump shall be capable of providing the following hydraulic conditions:
 Design Conditions
 620UMAN/RE
 M012282
 0.1-265 RPM
 0.002-4.75 GPM
 ANALOG SIGNAL OUTPUT

See Spec 214.3.9 All pumps, material and equipment to be salvaged shall be removed carefully to prevent damage, and then delivered to an area designated by the Plant Superintendent on site. The contractor shall dispose of all parts of the existing pump deemed unnecessary to the plant. The Plant Superintendent shall specify which parts of the existing pump are to be salvaged.


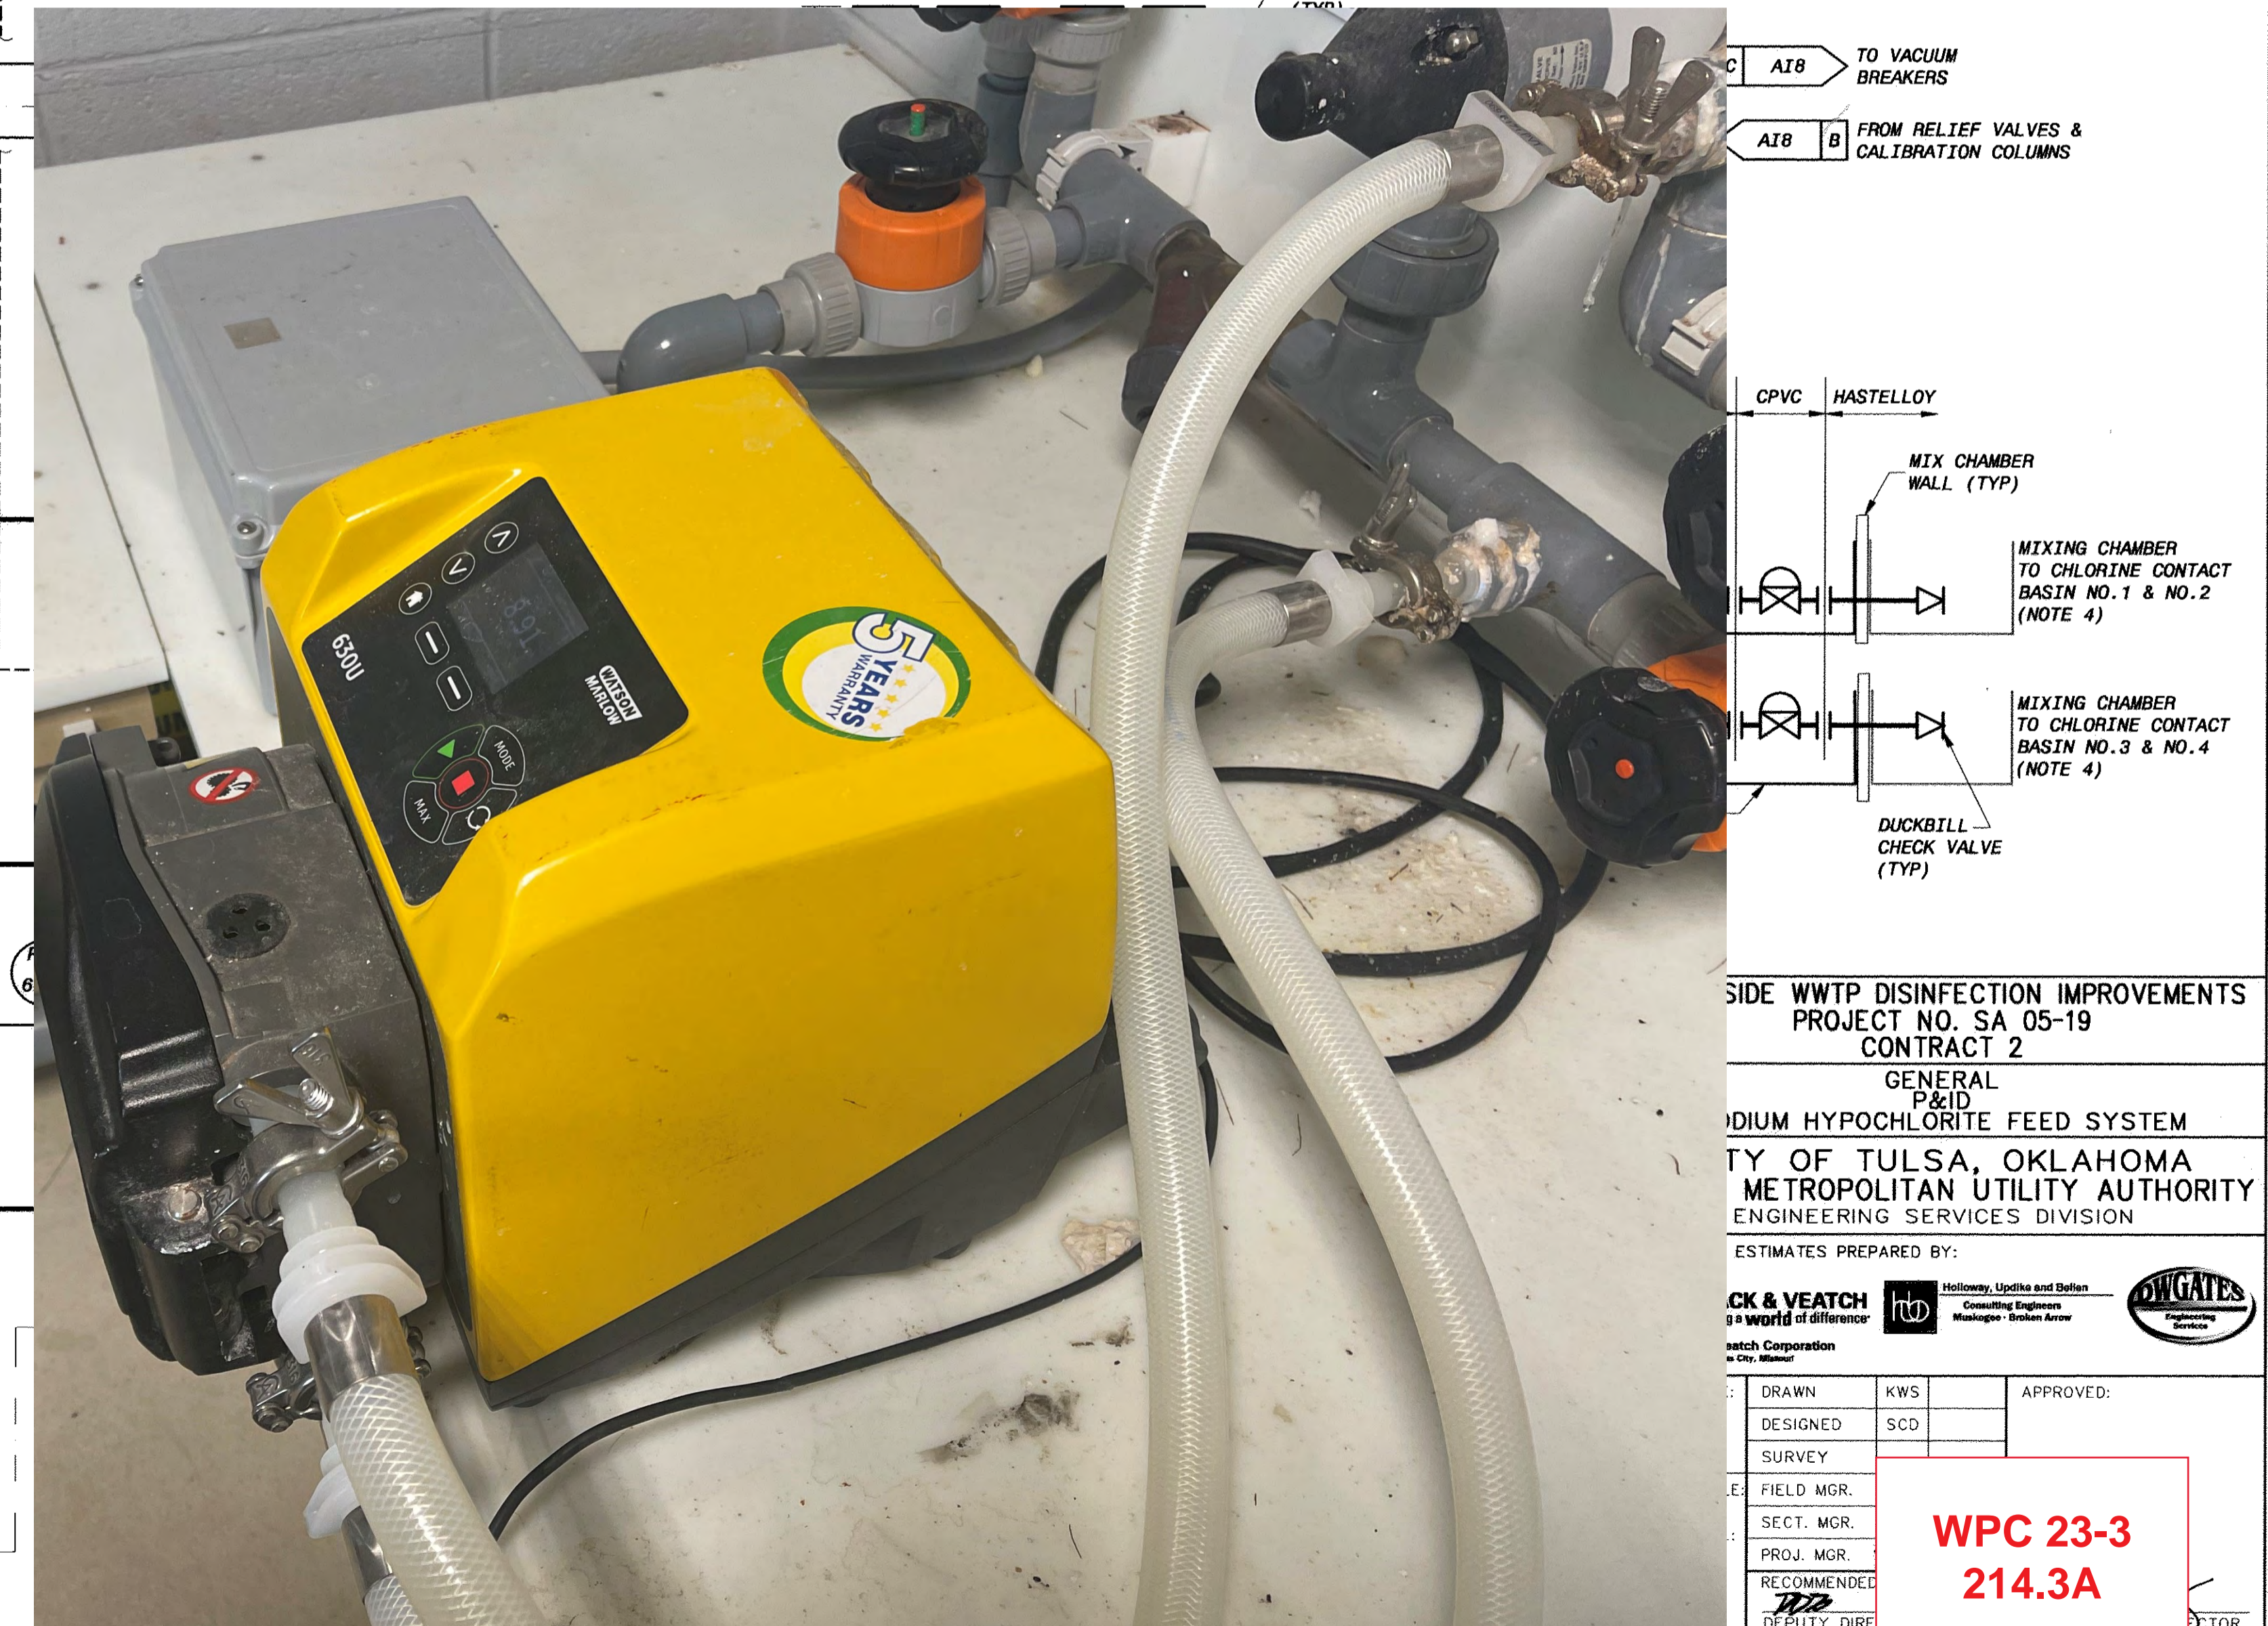


PLOTTED DATE: 3/22/2011 9:25:04 AM, Batch Plot
 SAVED DATE: 03/27/2011 12:17:20 PM, 2:44:02 PM
 C:\GNET\148537-3000-1\3000\148537

SIDE WWTP DISINFECTION IMPROVEMENTS
 PROJECT NO. SA 05-19
 CONTRACT 2
 GENERAL P&ID
 SODIUM HYPOCHLORITE FEED SYSTEM
 CITY OF TULSA, OKLAHOMA
 METROPOLITAN UTILITY AUTHORITY
 ENGINEERING SERVICES DIVISION
 ESTIMATES PREPARED BY:
 CK & VEATCH
 Holloway, Uppala and Sellan
 Consulting Engineers
 148537-3000-1
 B&V PROJECT NO. 148537

DESIGNED	SCD	APPROVED:
SURVEY		
FIELD MGR.		
SECT. MGR.		
PROJ. MGR.		
RECOMMENDED		
DEPUTY DIRE		

WPC 23-3
214.3A

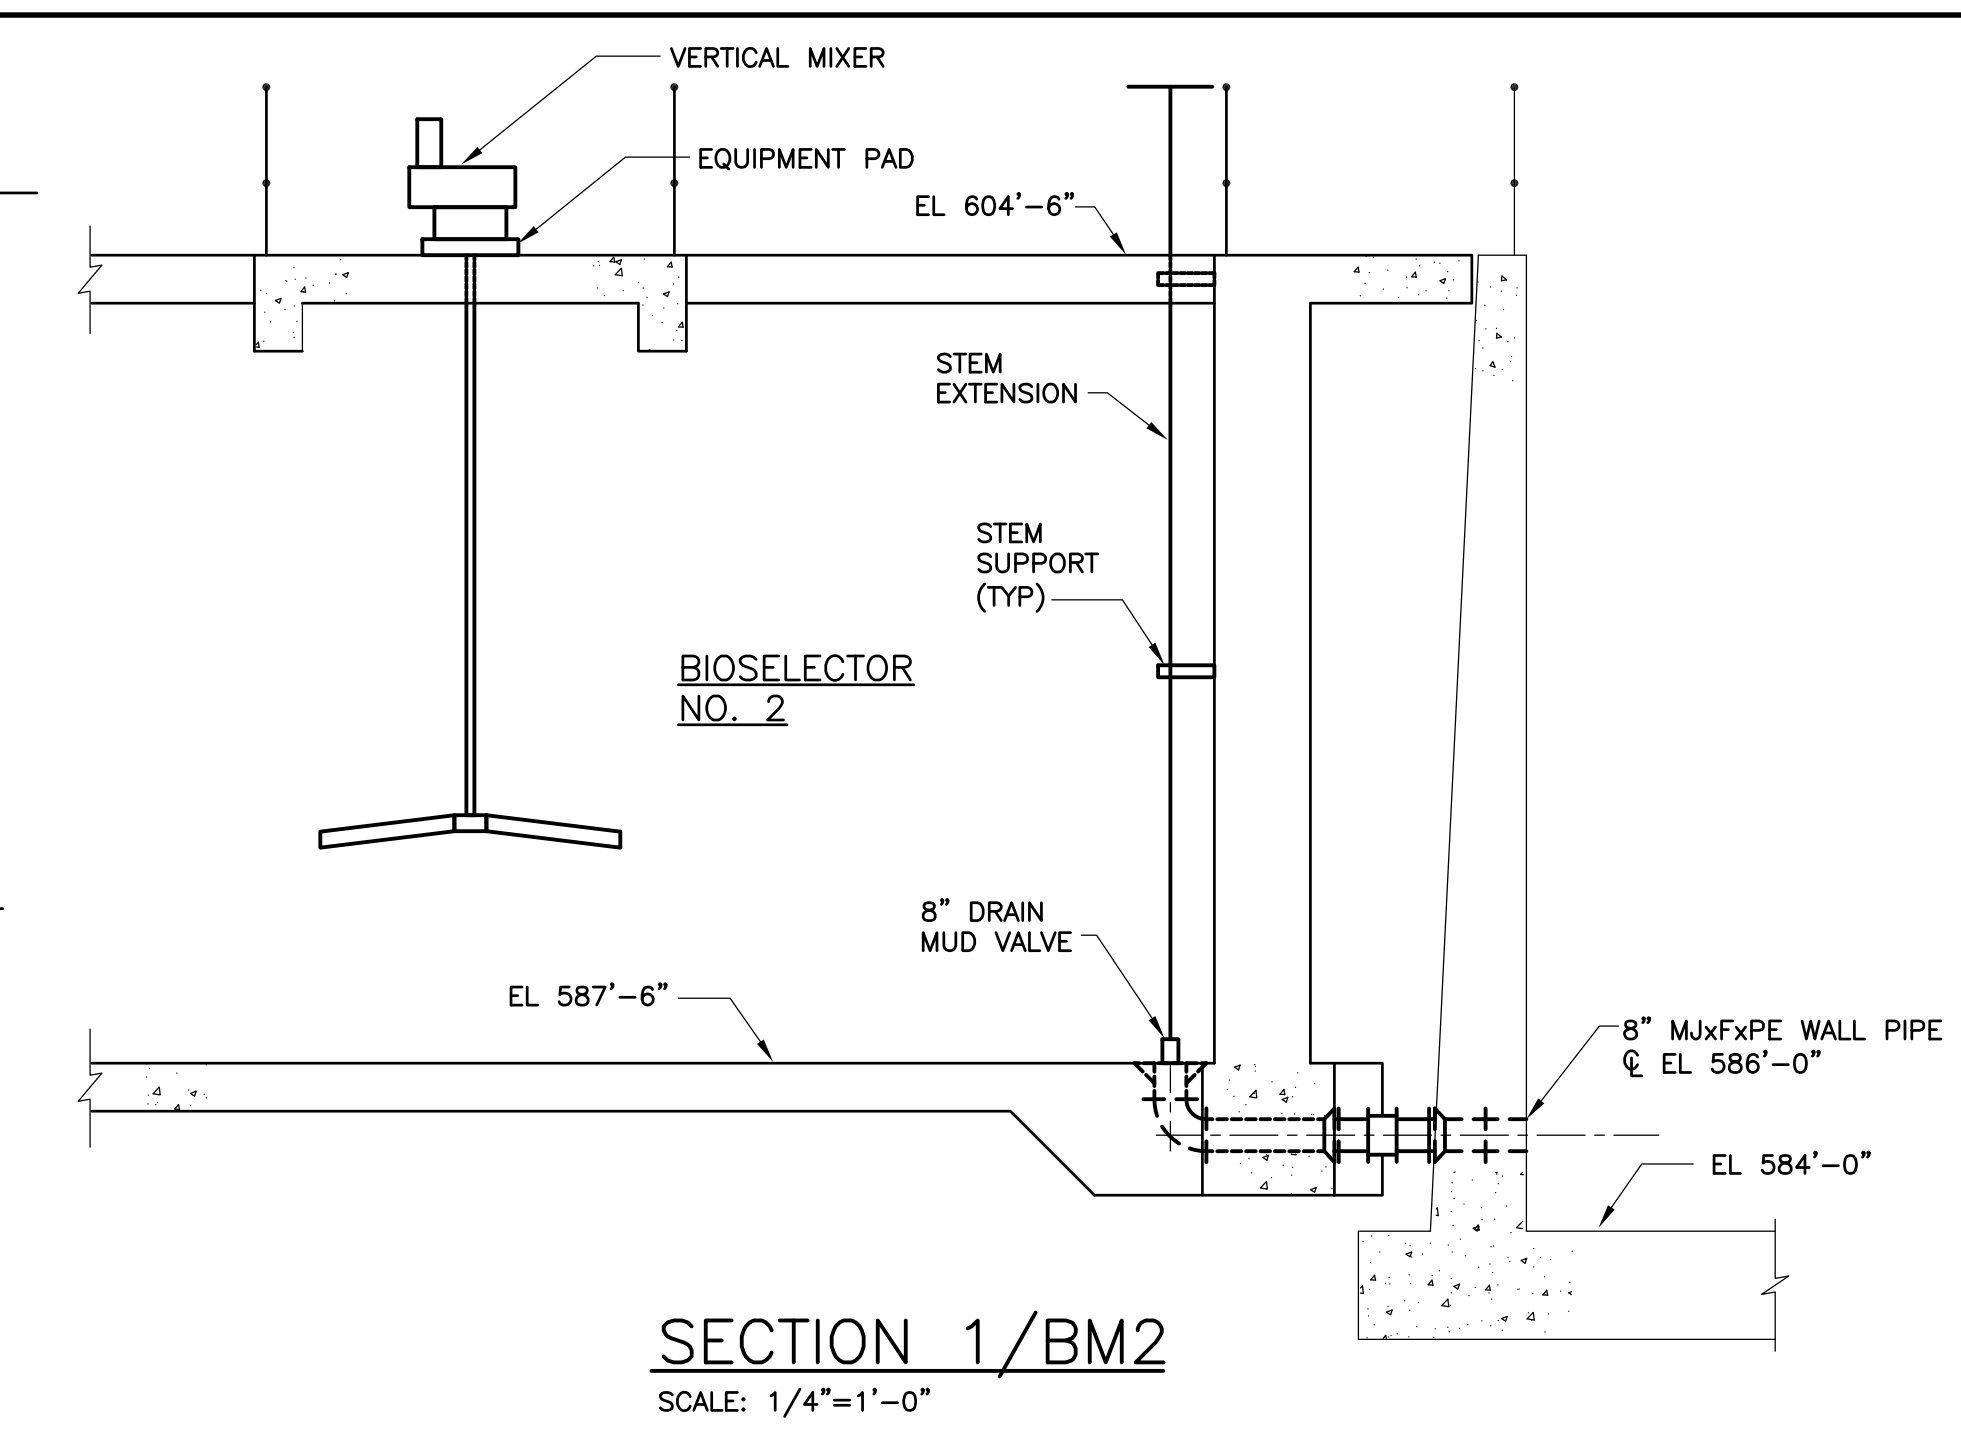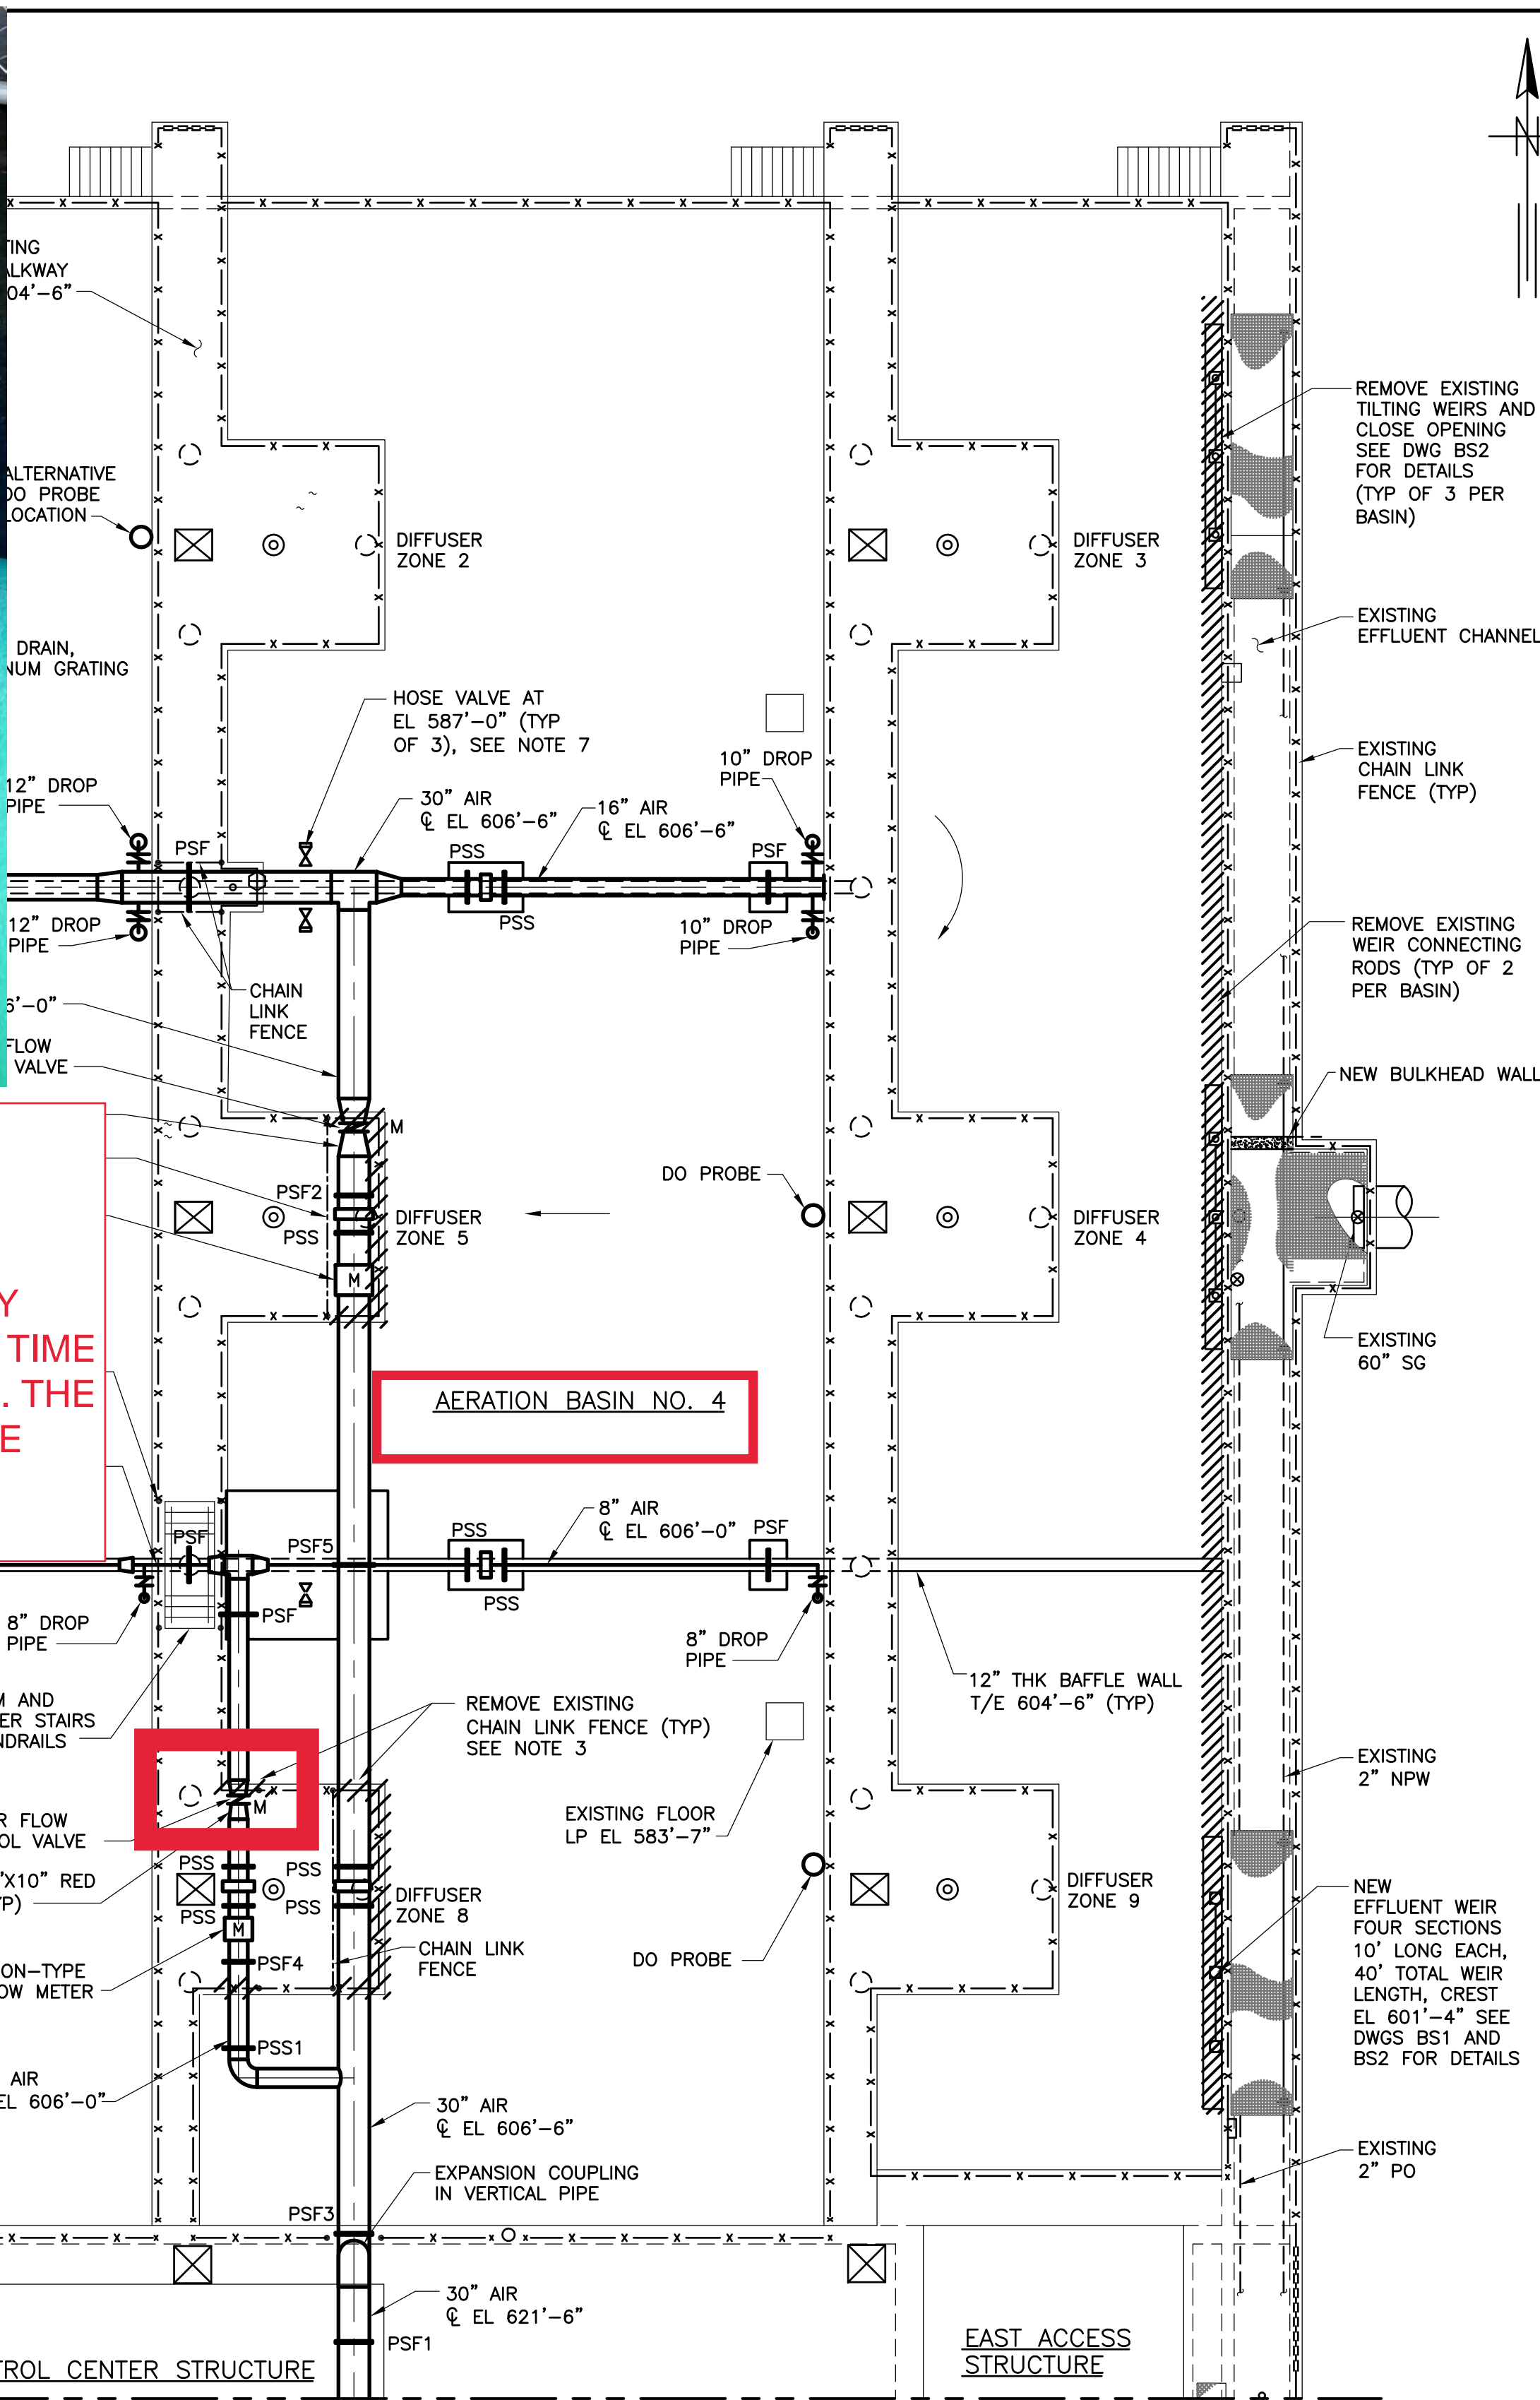

NOTES:

REMOVE & REPLACE:

SPEC 214.4.6.1 THE EXISTING ACTUATOR WAS MANUFACTURED BY AUMA SAR07.6/GS63.3/AM01.1 FLANGE FA12, BORE TO BE VERIFIED AT TIME OF ORDER FOR THE NORTHSLOPE WASTE WATER TREATMENT PLANT. THE NEW EQUIPMENT SHALL BE MANUFACTURED BY AUMA OR LIMITORQUE EQUAL.

NOTES:

- FILL HOLE IN PLATFORM WITH CONCRETE. SEE STRUCTURAL DETAIL 29. DISCONNECT EXISTING POWER SUPPLY AND CONTROL WIRING AT AERATOR/MIXER MOTOR. REMOVE EXPOSED CONDUIT AND ALL WIRING IF NOT REUSED. ABANDON AERATOR MIXER LUBRICATING SYSTEM PIPING IN PLACE. CUT AT WALKWAY SURFACE AND GROUTED WITH NON SHRINK.
- EXISTING WALL THICKNESS VARIES BETWEEN 1'-0" AT TOP AND 2'-0" AT BOTTOM. EXTEND WALL CASTING BEYOND FACE OF EXISTING WALL AS REQUIRED.
- REMOVE EXISTING 3'-6" HIGH PIPE RAILING AND CHAIN LINK FENCE AS NEEDED AT LOCATIONS WHERE IT INTERFERES WITH NEW AIR PIPING. INSTALL NEW END POSTS, TOP AND BOTTOM RAILS, AND FENCE FABRIC MATCHING EXISTING TO REPAIR.
- SEE DWG BM1 FOR TYPICAL TANK AND NEW PIPING DIMENSIONS. DIMENSIONS TO BE FIELD VERIFIED.
- SEE DWGS BM1 AND BM2 FOR LOCATIONS OF TYPICAL SECTION CUTS FOR AIR PIPING, CHAIN LINK FENCE, AND WEIR PLATE. SECTIONS SHOWN ON DWG BM5.
- SEE DWG BS6 FOR STRUCTURAL PIPE SUPPORT DETAILS. PSF = FIXED SUPPORT
PSS = SLIDING SUPPORT
- SEE DWG BM5 FOR AERATION BASIN FLUSHING WATER SYSTEM DETAILS.
- PROVIDE FINE PORE AIR DIFFUSER EQUIPMENT ARRANGED TO PROVIDE FULL FLOOR COVERAGE. AERATION ZONE DESIGNATIONS:
- PROVIDE ADDITIONAL FLANGED JOINTS AS NEEDED TO FACILITATE THE TRANSPORT AND ASSEMBLY OF AIR PIPING.

REUSED. ABANDON AERATOR MIXER LUBRICATING SYSTEM PIPING IN PLACE. CUT AT WALKWAY SURFACE AND GROUTED WITH NON SHRINK.

RECORD DRAWING

THIS RECORD IS NOT WARRANTED BUT IS BELIEVED TO REPRESENT CONDITIONS UPON COMPLETION OF CONSTRUCTION WITHIN REASONABLE TOLERANCES. BASED UPON THE INFORMATION FURNISHED TO THE ENGINEER PERTAINING TO CHANGES MADE DURING CONSTRUCTION.

**AERATION BASINS AND BIOSELECTORS
PIPING AND EQUIPMENT**

FLOW TRAIN 4 PLAN AND SECTION

**NORTHSIDE WWTP
NITRIFICATION IMPROVEMENTS**


PROJECT NO. ES 2003-12

**CITY OF TULSA, OKLAHOMA
PUBLIC WORKS DEPARTMENT
ENGINEERING SERVICES DIVISION**

PLANS AND ESTIMATES PREPARED BY:
GREELEY AND HANSEN
100 SOUTH WACKER DRIVE, SUITE 1400


1	2	3
6	5	4
7	8	9

TOP PLAN
SCALE: 3/32"=1'-0"

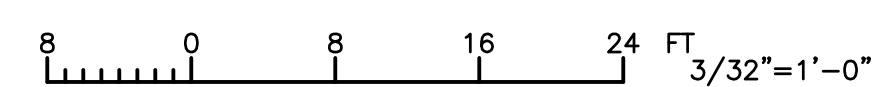

REVISION	BY	DATE
RECORD DWG REVS	TJN	3/

**WPC23-3
214.4A**

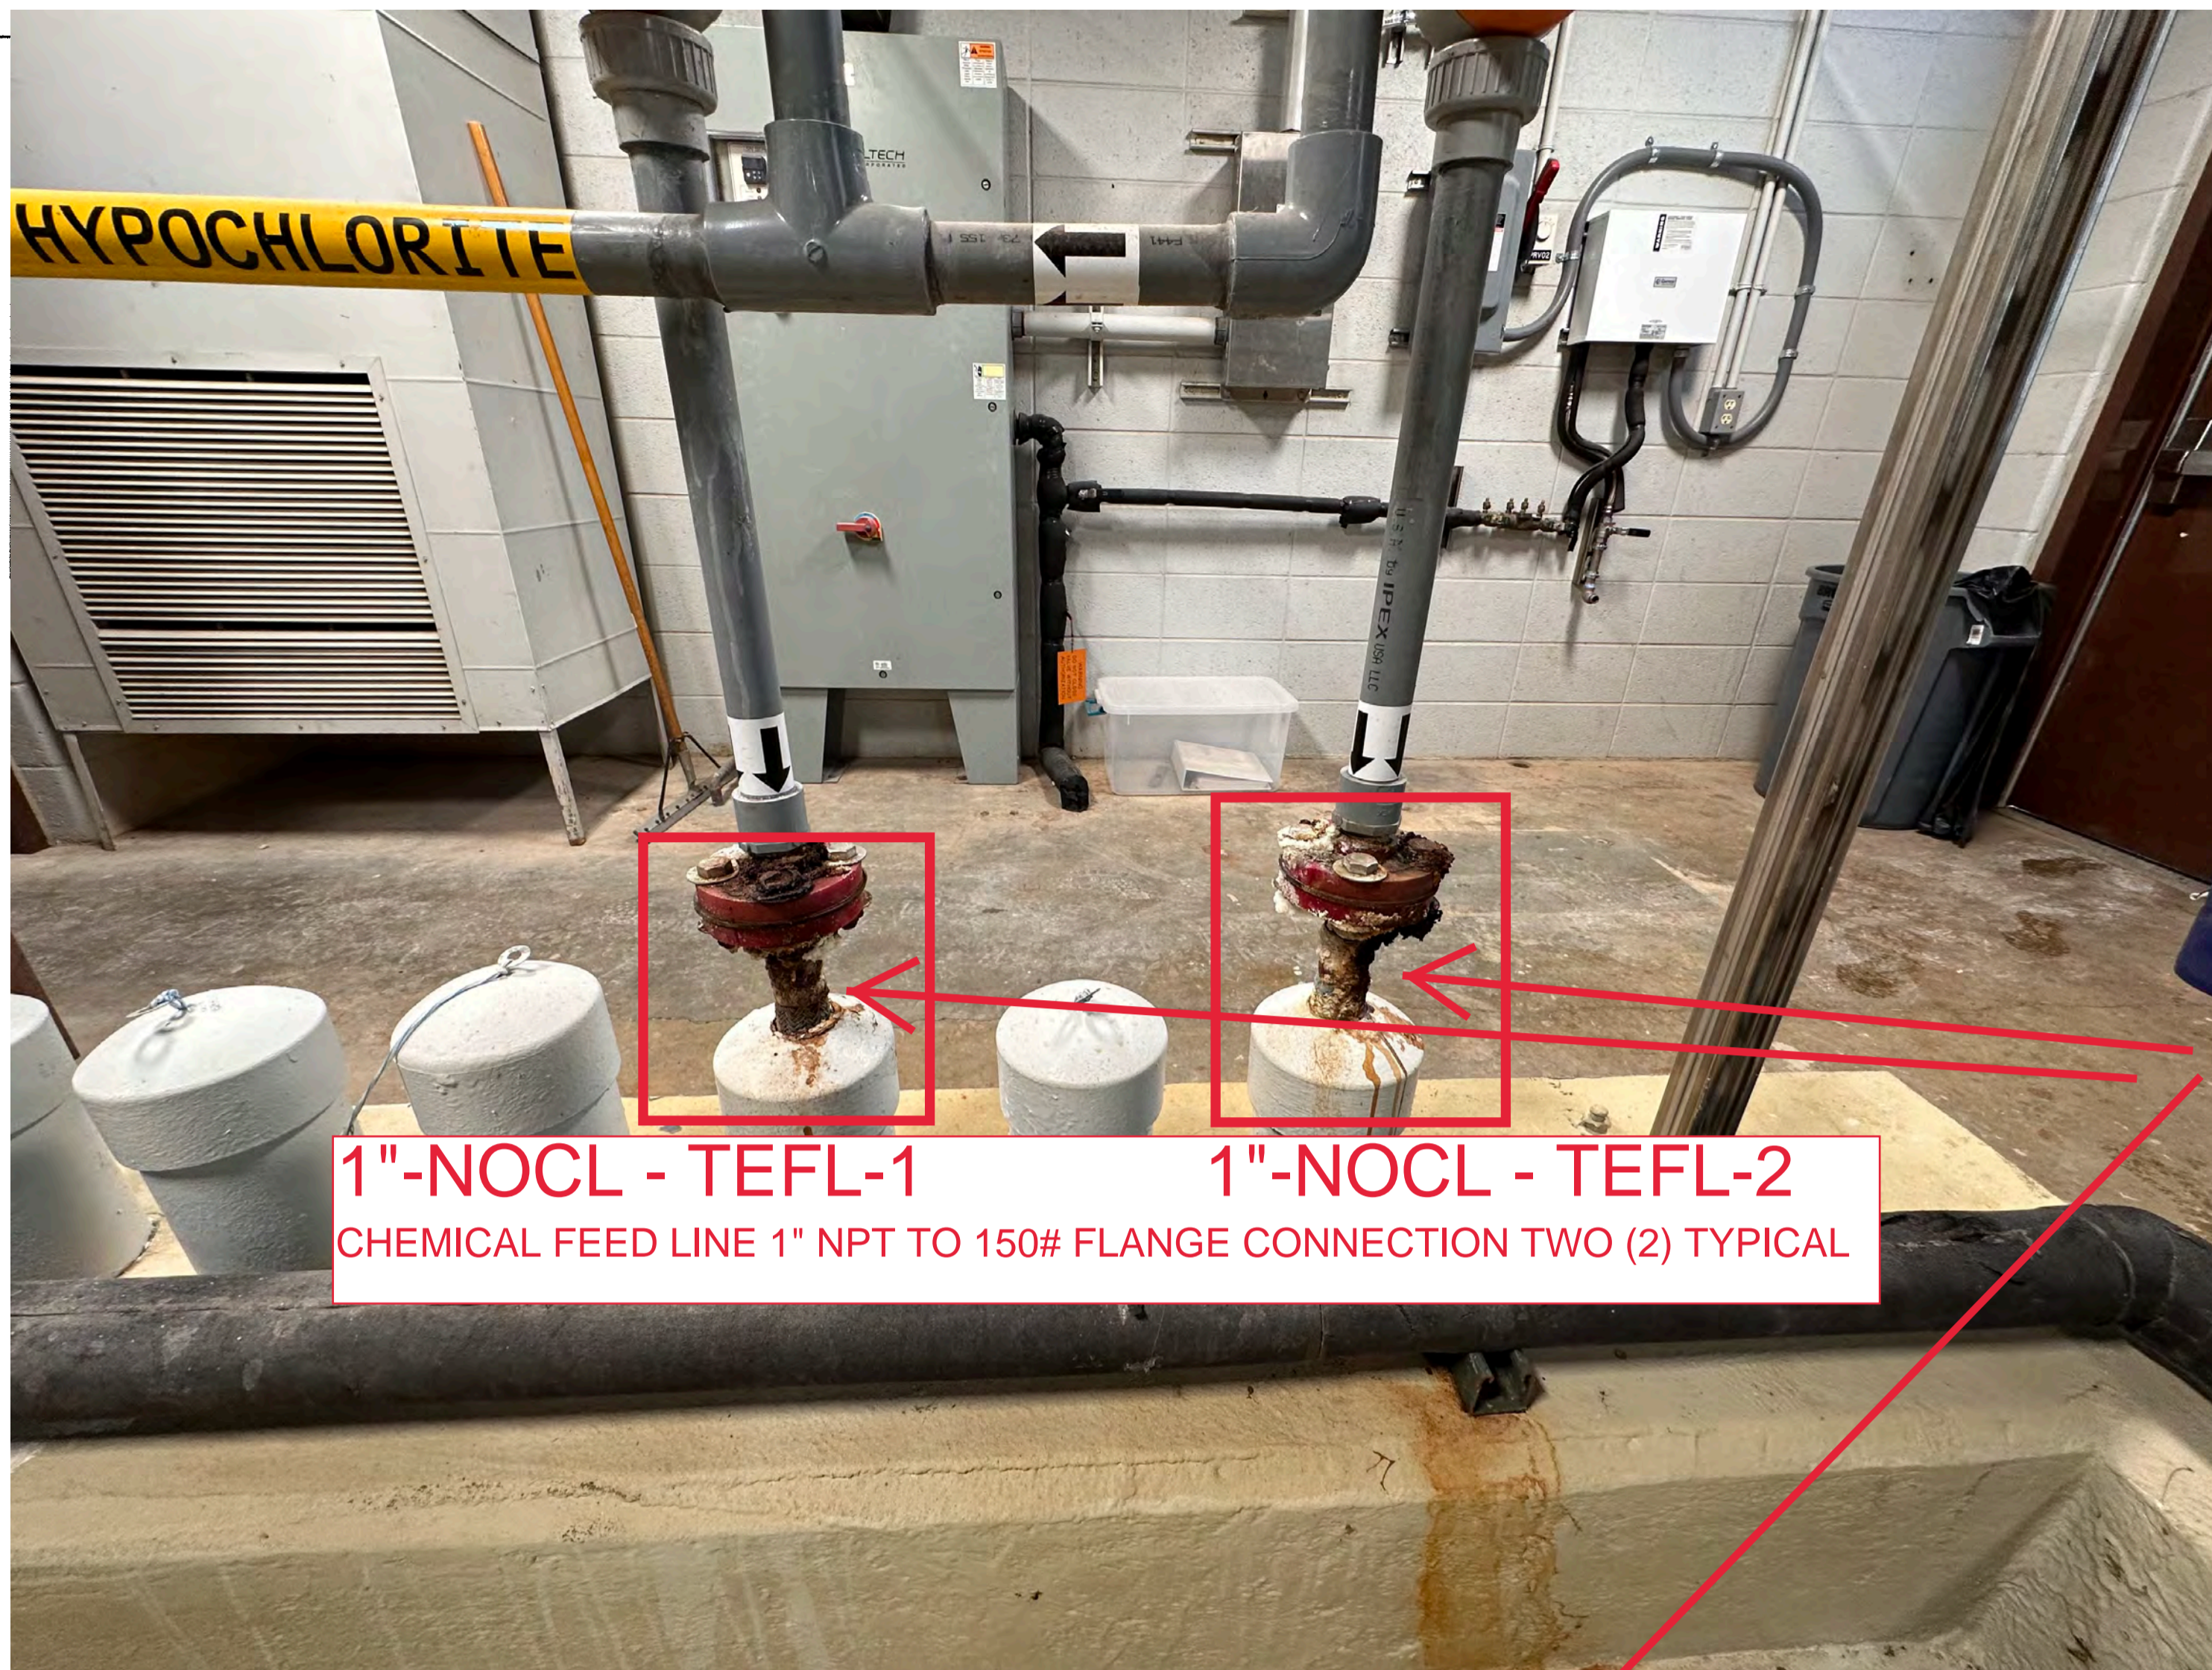

1"-NOCL - TEFL-1 **1"-NOCL - TEFL-2**
 CHEMICAL FEED LINE 1" NPT TO 150# FLANGE CONNECTION TWO (2) TYPICAL

NOTES:
 ALL MARKINGS ARE APPROXIMATE AND MAY NOT BE COMPLETE. CONSULT WITH ENGINEER IF UNCLEAR

REMOVE AND REPLACE:

TWO(2) TYPICAL:
 1" NPT X 150# RF FLANGE TUBING TO BE POLYPROPYLENE BRAIDED, CONVOLUTED PFA TEFLON TUBING; PUREFLEX INC "PROFLEX" OR EQUAL. FACTORY SPLICE CONNECTIONS SHALL BE ACCOMPLISHED USING PROFLEX STYLE 11 FITTINGS CONSTRUCTED OF SOLID KYNAR

REPLACE FASTENERS WITH HASTELLOY NUT, BOLT, & WASHERS
GASKET TO BE VITRON OR APPROVED EQUIVALENT

TWO(2) TYPICAL:
 1" SLIP ON CHECK VALVE SHALL BE AS MANUFACTERED BY TIDEFLEX INDUSTRIES SERIES 35 OR SERIES TF-2 OR EQUAL

NOTE:
 SEE LEGEND ON DRAWINGS AT1, AT2, AND AT3


SHALL BE ROUTED TO SLOPE CONTINUOUSLY
 TION OF FEED POINTS.
 , LOCATED ON MCCS OR AT EQUIPMENT,

ET HIGHER THAN THE TOP OF

HE ISOLATION VALVE AT EACH PRESSURE
 ND THREADED CAP ON THE BRANCH OF THE
 LLE LOCKABLE.

AT8 TO VACUUM
 BREAKERS

AT8 FROM RELIEF VALVES &
 CALIBRATION COLUMNS

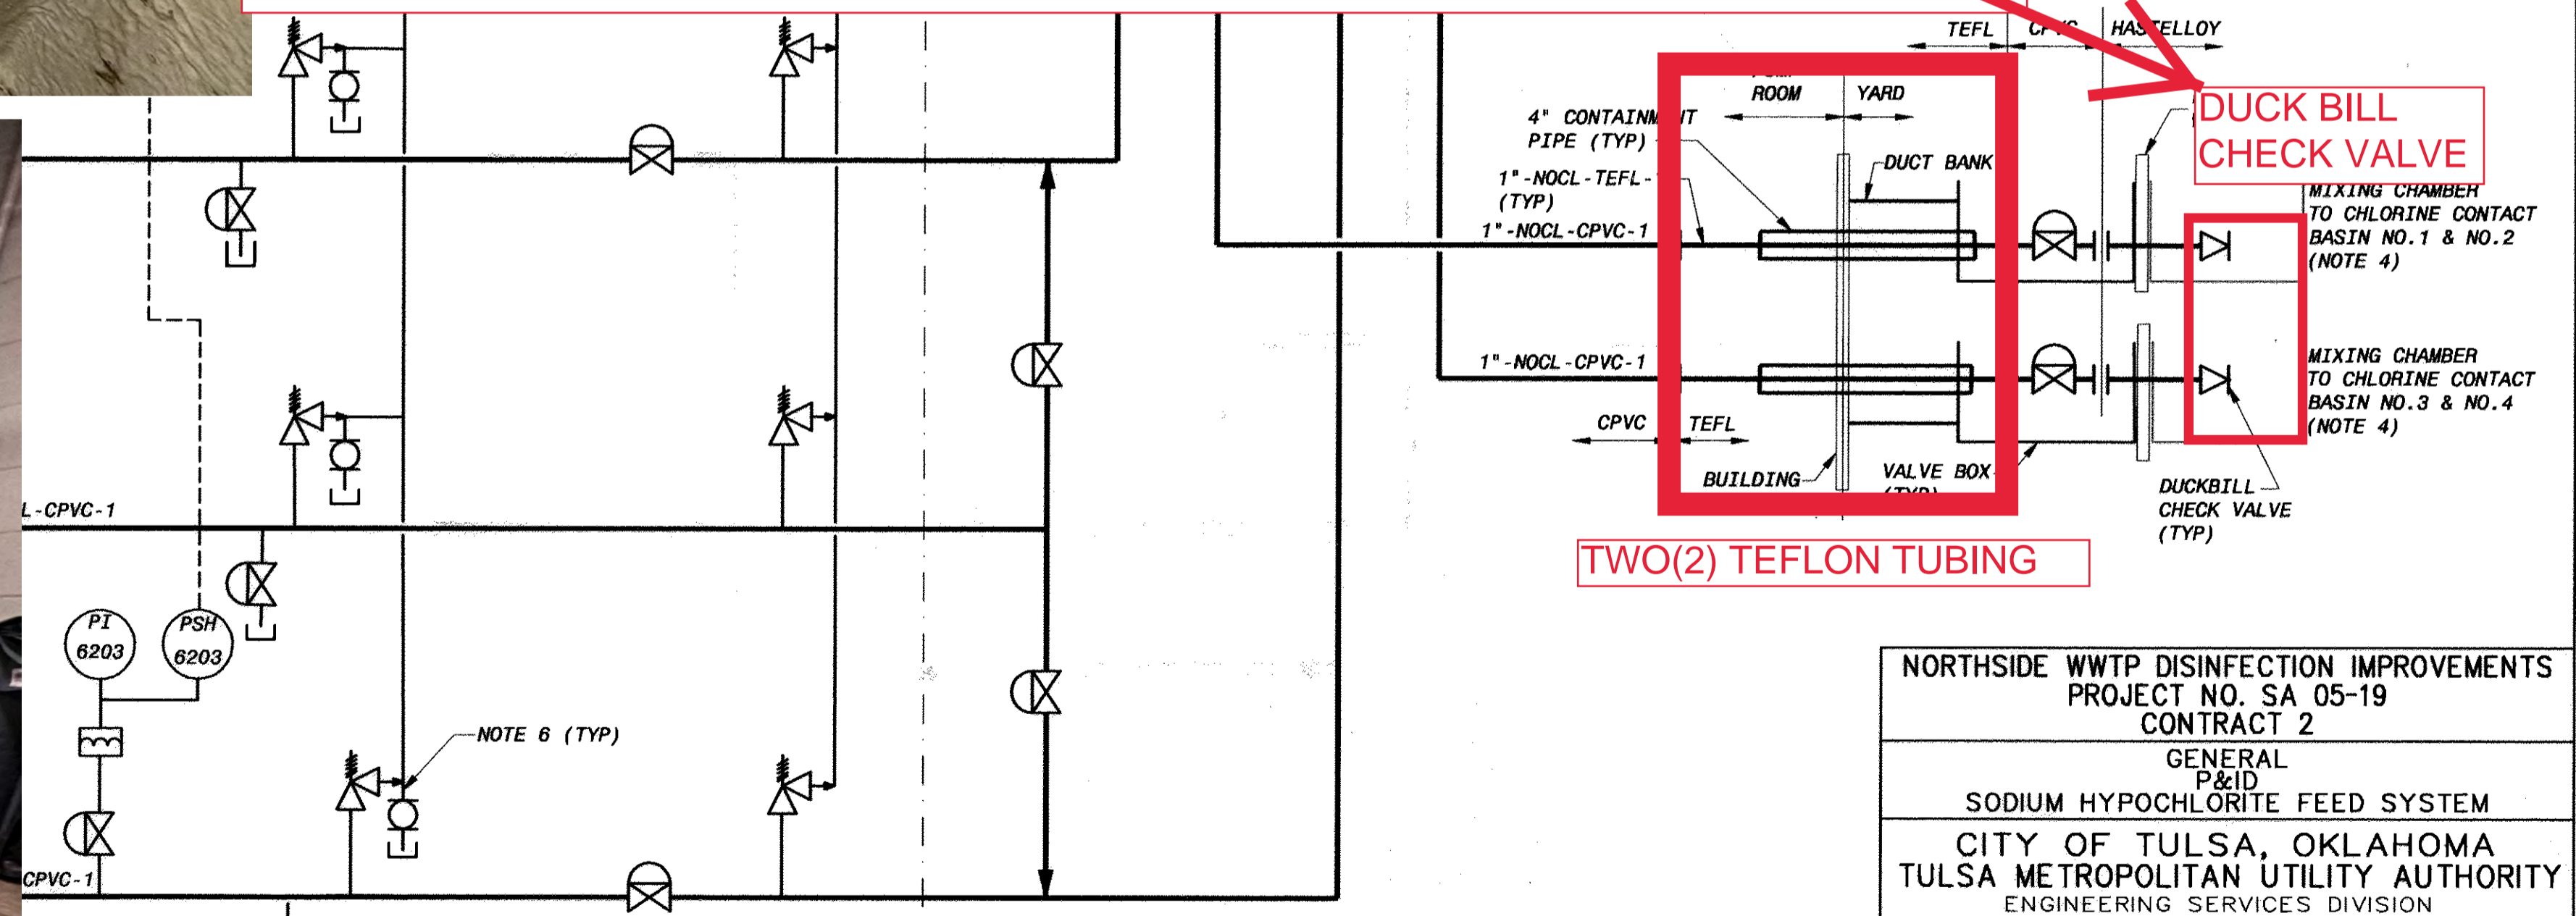

TWO(2) TEFLON TUBING


NORTHSIDE WWTP DISINFECTION IMPROVEMENTS
PROJECT NO. SA 05-19
CONTRACT 2

GENERAL
SODIUM HYPOCHLORITE FEED SYSTEM

CITY OF TULSA, OKLAHOMA
TULSA METROPOLITAN UTILITY AUTHORITY
ENGINEERING SERVICES DIVISION

PLANS AND ESTIMATES PREPARED BY:

**RECORD
 DRAWING**

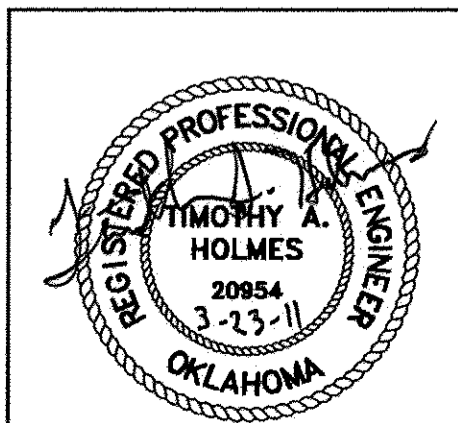

REVISION	BY	DATE

WPC 23-3
214.5A

DATE **APRIL 15, 2011**

SHEET 14 OF 84 SHEETS

ATLAS PAGE NO: **3-90-11**

B&V PROJECT NO. 148537

PLOTTED DATE: 3/22/2011 8:25:04 AM, Batch Plot
 SAVED DATE: 03/27/2011 12:17:20 PM, 2:24:02 PM
 D:\148537\000-1\000\148537.DWG

NORTH BASIN TYPICAL CONNECTION POINT OF TUBING



- NOTES:
1. PAVEMENT AND CURB REMOVAL AND REPLACEMENT SHALL BE IN STRICT ACCORDANCE WITH CITY OF TULSA PUBLIC WORKS DEPARTMENT CONSTRUCTION SPECIFICATIONS AND STANDARD DRAWINGS LATEST EDITION.
 2. ALL PIPING SHOWN AS ABANDONED SHALL BE CUT AND CAPPED WHERE EXPOSED.
 3. LOCATION OF EXISTING BURIED PIPING SHOWN IS APPROXIMATE. CONTRACTOR SHALL VERIFY AND NOTIFY ENGINEER OF DISCREPANCIES.
 4. EXISTING PIPES AND OTHER SUBSURFACE FEATURES ARE NOT SHOWN IN PROFILE. CONTRACTOR SHALL VERIFY DEPTHS AND ADJUST ELEVATION OF PROPOSED CHEMICAL DUCT BANK AND WATER LINES AS REQUIRED.
 5. ALL CHEMICAL DUCT BANK SHOWN IS BURIED.

CHEMICAL DUCT COORDINATE TABLE		
ID	NORTHING	EASTING
A	458348.62	2600736.86
B	458350.96	2600736.80
C	458354.03	2600739.73
D	458355.40	2600799.26
E	458351.49	2600803.37
F	458272.11	2600805.61

CHEMICAL DUCT COORDINATE TABLE		
ID	NORTHING	EASTING
A	458172.16	2600955.26
B	458171.80	2600939.84
C	458168.41	2600937.91
D	458153.93	2600756.16
E	458146.43	2600756.27
F	458139.59	2600763.37


NOTES:
 ALL MARKINGS ARE APPROXIMATE AND MAY NOT BE COMPLETE. CONSULT WITH ENGINEER IF UNCLEAR

TUBING TO BE POLYPROPYLENE BRAIDED, CONVOLUTED PFA TEFLON TUBING; PUREFLEX INC "PROFLEX" OR EQUAL. FACTORY SPLICE CONNECTIONS SHALL BE ACCOMPLISHED USING PROFLEX STYLE 11 FITTINGS CONSTRUCTED OF SOLID KYNAR

TOTAL TUBE LENGTH TO BE LONG ENOUGH TO DRAPE OVER CONTACT BASIN WALL

CHECK VALVE SHALL BE AS MANUFACTERED BY TIDFLEX INDUSTRIES SERIES 35 OR SERIES TF-2 OR EQUAL

SOUTH BASIN TYPICAL CONNECTION POINT OF TUBING

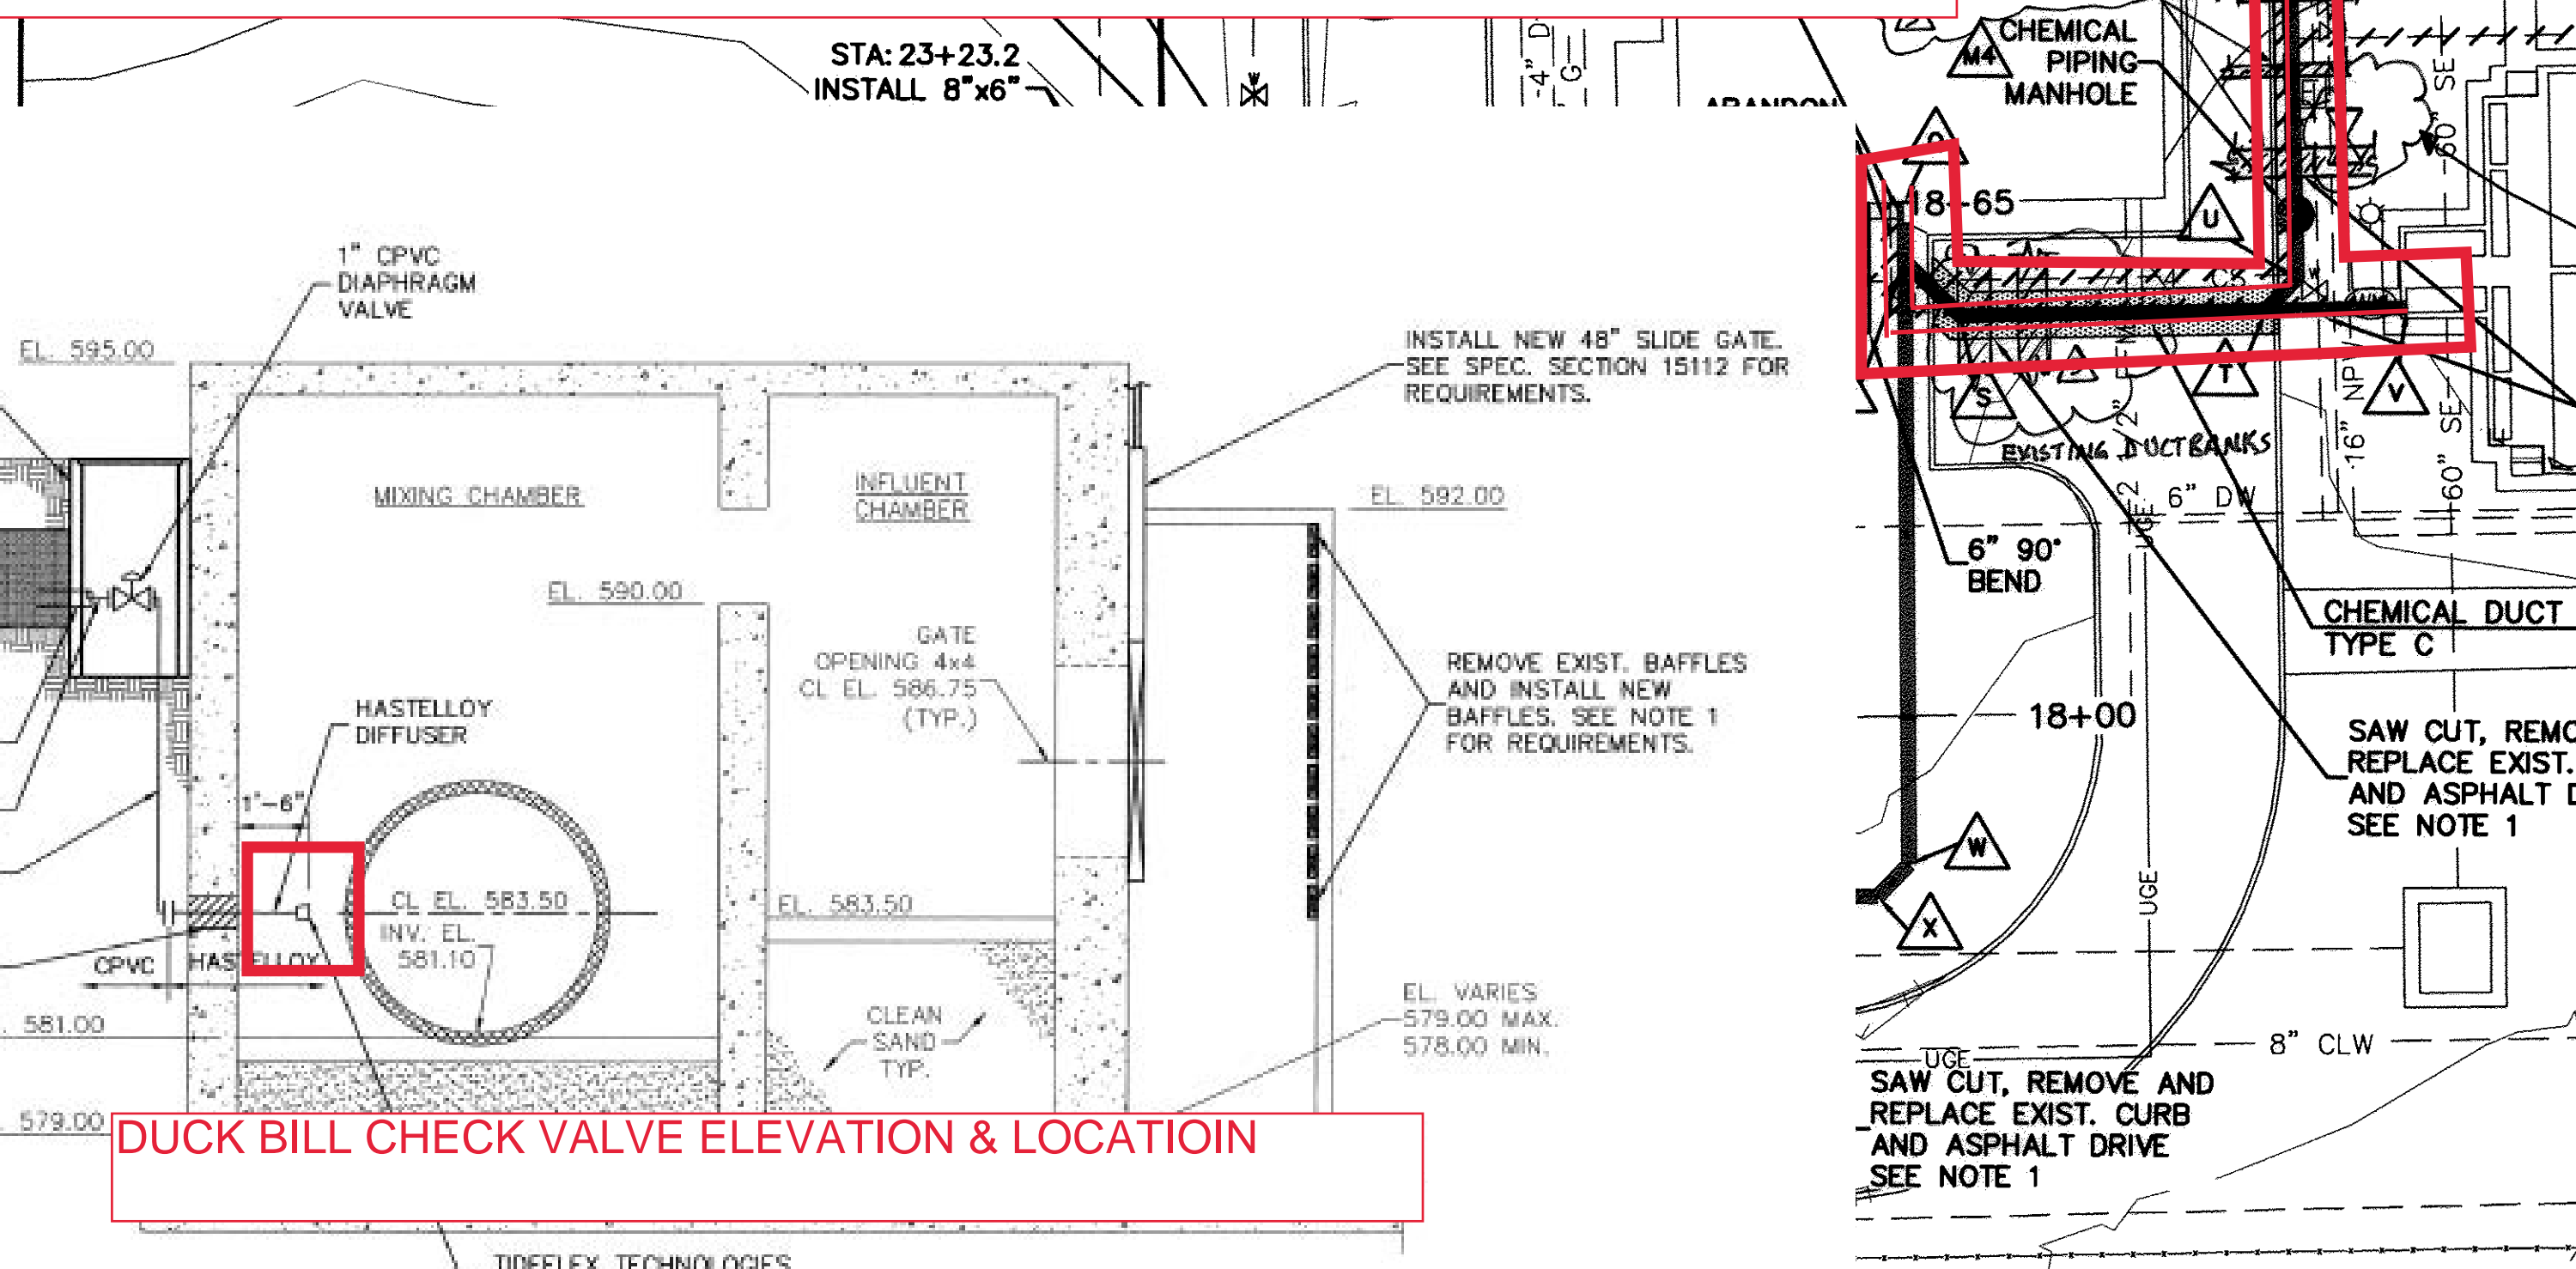

DUCK BILL CHECK VALVE ELEVATION & LOCATION

SECTION - MIXING CHAMBER, BASINS 3&4 (BASINS 1&2 SIMILAR)
 SCALE: 3/8" = 1'-0"

SURVEY CONTROL COORDINATE TABLE				
ID	NORTHING	EASTING	ELEVATION	SHEET
BM-1	458275.70	2600741.23	592.80	BC2
CP-1	458271.12	2600750.52	593.10	BC2
CP-2	458087.25	2600441.42	603.17	BC5



REVISION	BY	DATE	PLAN SCALE
AS BUILT'S	RM	11 APR 03	1"=20'
BY FIELD CHANGE	RM	10 APR 03	
FIELD CONDITIONS	RM	12 APR 03	

**WPC 23-3
214.5 B**

INSTALLING AND BE INCLUDED IN