

TULSA METROPOLITAN UTILITY AUTHORITY

175 E. 2nd Street

TULSA, OKLAHOMA 74103

April 1, 2026

**ADDENDUM 1
TO
TULSA METROPOLITAN UTILITY AUTHORITY
PROJECT NO. WPC 26-4
FY'26 WATER POLLUTION CONTROL
SOUTHSLOPE CAPITAL EQUIPMENT REPLACEMENTS**

This Addendum 1 consisting of nine (9) items is, hereby, made a part of the Contract Documents to the same extent as though it were originally included, therein, and shall supersede anything contained in the Plans and Specifications with which it might conflict. Receipt of this Addendum 1 shall be denoted in Bidder's Proposal. Failure to do so will result in the bid being deemed non-responsive.

All other provisions of the Plans and Specifications shall remain in full force and effect.

CITY OF TULSA WATER AND SEWER DEPARTMENT



Cindy Cantero
Water Pollution Control Manager



WATER AND SEWER

DATE:

April 1, 2026

Ms. Cindy Cantero
Water Pollution Control Section Manager
175 East 2nd Street, 13th Floor
Tulsa, Oklahoma 74103

RE: TMUA PROJECT NO. WPC 26-4, FY'26 SOUTHSLOPE CAPITAL EQUIPMENT REPLACEMENTS
SUBJECT: ADDENDUM 1 - 4/1/2026

Dear Ms. Cantero:

This Addendum 1 consisting of nine (9) items is, hereby, made a part of the Contract Documents to the same extent as though it were originally included, therein, and shall supersede anything contained in the Plans and Specifications with which it might conflict. Receipt of this Addendum 1 shall be denoted in Bidder's Proposal. Failure to do so will result in the bid being deemed non-responsive.

1. Pre-Bid Conference Bidder Question #1
 - a. Question: "Will you please clarify the Basis of Award?"
 - b. Response: Refer to the Proposal, page P-2, paragraph titled "Basis of Award."
2. Pre-Bid Conference Bidder Question #2
 - a. Question: "Are bidders required to submit two printed copies of their Proposal?"
 - b. Response: No, submit one (1) printed hardcopy of your bid proposal forms.
3. Pre-Bid Conference Bidder Question #3
 - a. Question: "Are bidders required to submit an electronic flash drive with their Proposal?"
 - b. Response: No, do not submit an electronic flash drive.
4. Pre-Bid Conference Bidder Question #4
 - a. Question: "What is to be done with the existing electrical conduit and box located at the scum pit?"
 - b. Response: Remove and replace junction box and a portion of conduit run as shown in Addendum 1, revised Sheet 4 and revised Sheet 5.
5. Pre-Bid Conference Bidder Question #5
 - a. Question: "Will the existing damper on the Odor Control Piping at the scum pit need to be reinstalled? If so, this will require an additional pipe spool in order to get the attachment flange at the right elevation."
 - b. Response: Yes, the existing damper shall be reinstalled. Add a PVC spool pipe as shown in Addendum 1, revised Sheet 5.
6. Pre-Bid Conference Bidder Question #6
 - a. Question: "The existing pressure gauges [on STP01 discharge and on STP02 discharge] are installed on isolation rings. Are the new gauges to be installed on isolation rings as well? Do you have P&ID drawings available of this area [of Digester 3&4]?"

1836 x 1898

TUL x USA



- b. Response: Yes, install pressure gauges and switches on isolation rings to match the existing configuration. And, yes, Owner will provide available information regarding existing equipment during construction.
- 7. Refer to SHEET 4 - ADD. ALT. #1 SCUM PIT HATCH REPLACEMENT
 - a. Replace entire drawing with the attached drawing.
 - b. Revise C - DEMOLITION PLAN as shown on the revised drawing.
 - c. Add D - I/O CABLE PRESERVATION NOTES as shown on the revised drawing.
- 8. Refer to SHEET 5 - ADD. ALT. #1 SCUM PIT HATCH REPLACEMENT
 - a. Replace entire drawing with the attached drawing.
 - b. Revise B - SCUM PIT HATCH PLAN as shown on the revised drawing.
- 9. Refer to SHEET 7 - CC MAKE-UP AIR UNIT REPLACEMENT
 - a. Replace entire drawing with the attached drawing.
 - b. Revise B - EXISTING ROOF PLAN as shown on the revised drawing.

Sincerely,




Samuel H. Ray, P.E., S.E.

1836 x 1898


TUL x USA



VIEW LOOKING NORTHEAST

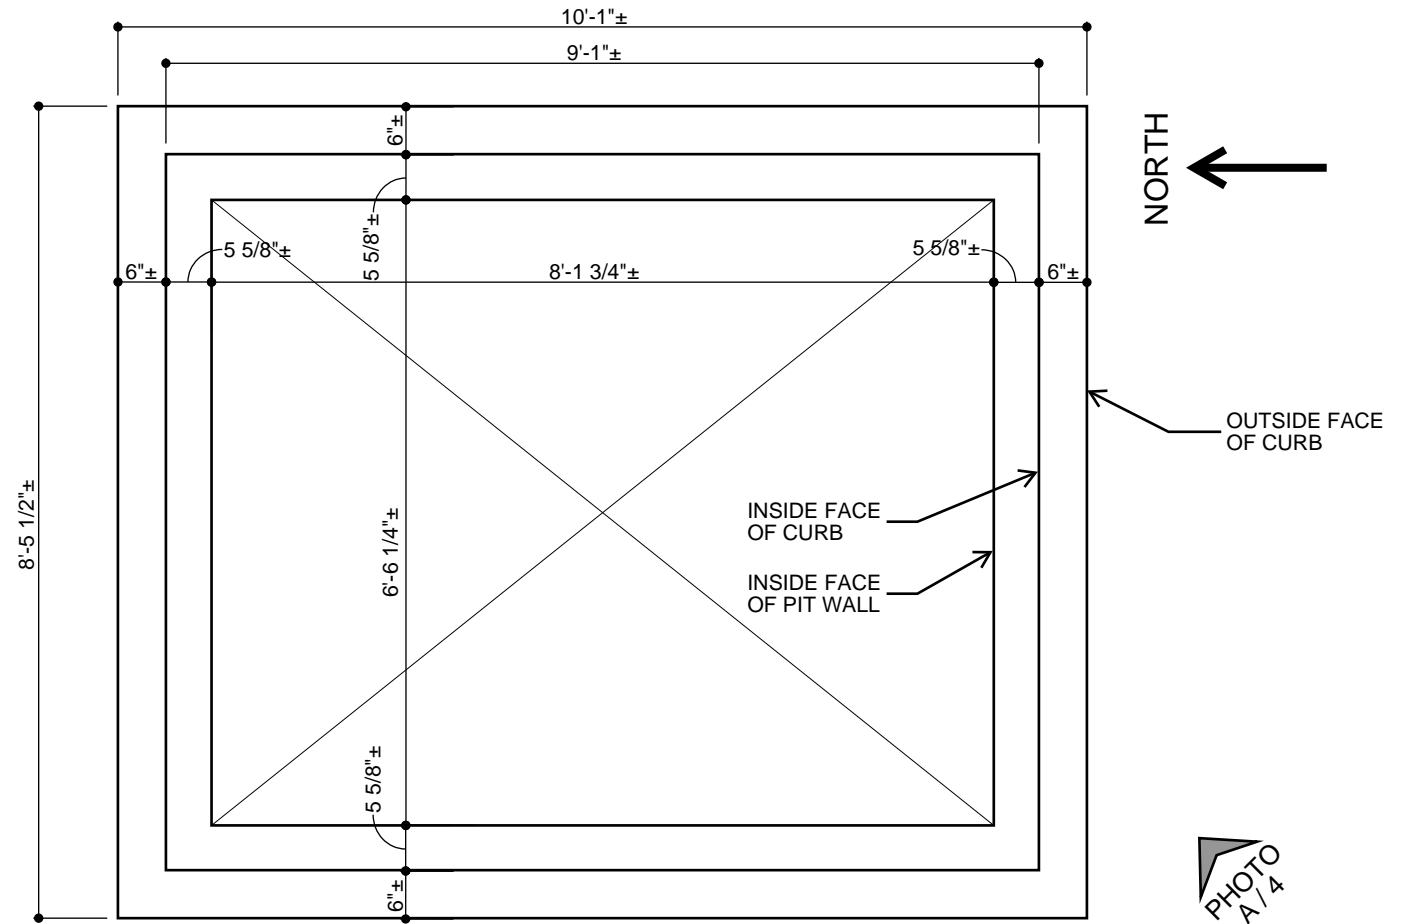

B EXISTING SCUM PIT PLAN

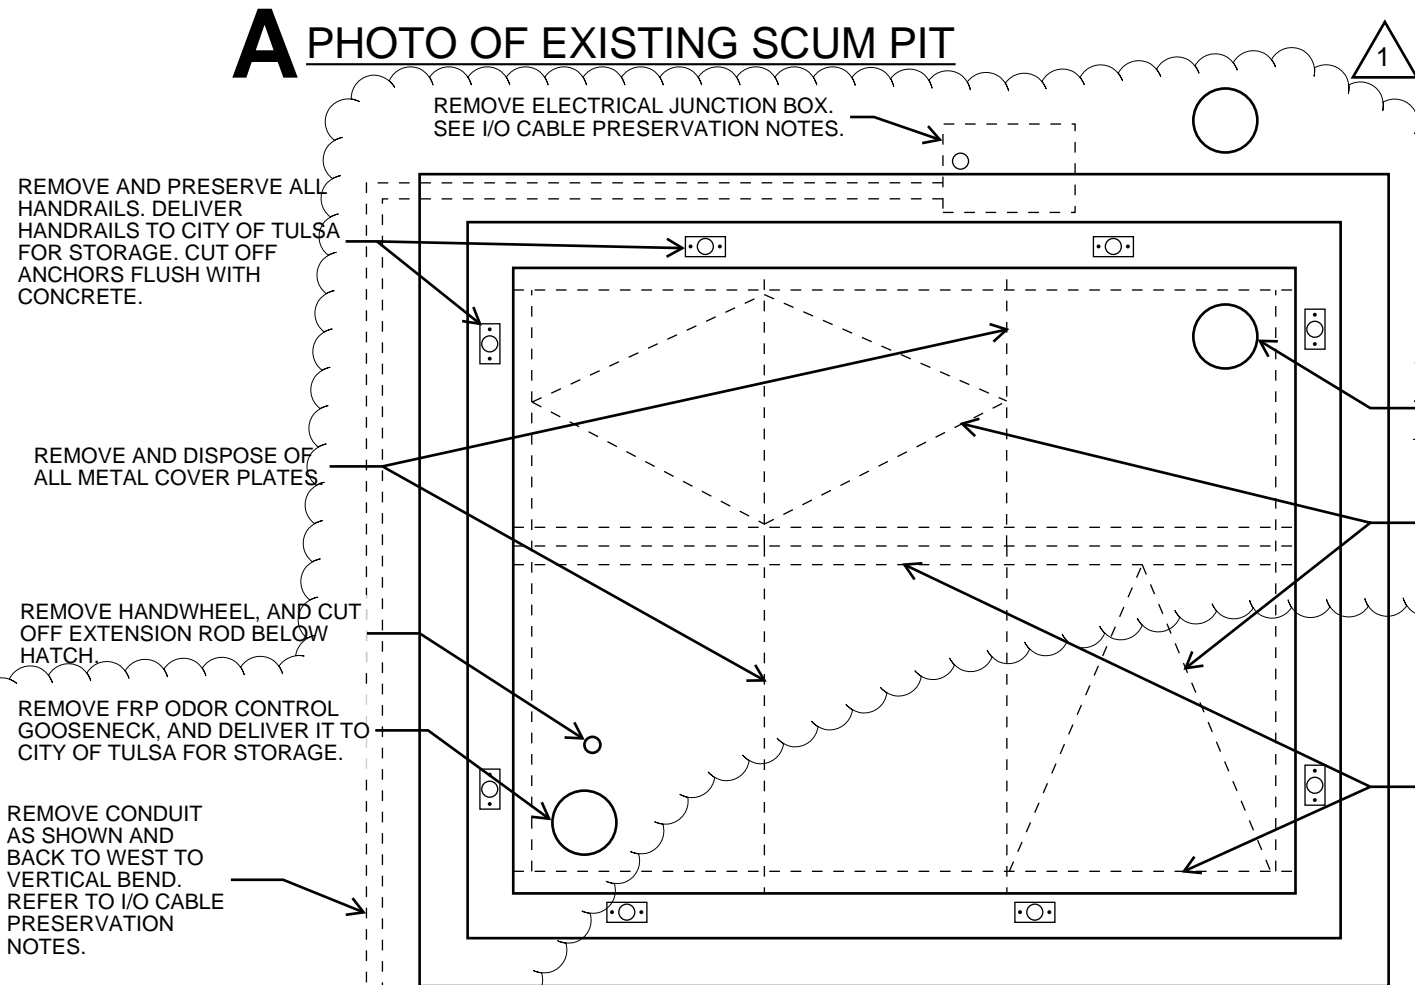

C DEMOLITION PLAN


1. THE EXISTING CONDUIT AND ELECTRICAL JUNCTION BOX CONTAIN AN I/O CABLE THAT IS IN SERVICE AND SHALL BE PRESERVED.
2. COORDINATE THE SCHEDULING OF THIS WORK WITH PLANT STAFF.
3. DISCONNECT CABLE FROM ITS TERMINAL END IN CABINET RIO10 IN WEST PUMP HOUSE.
4. WITHDRAW CABLE FROM CONDUIT AND JUNCTION BOX TO FACILITATE DEMOLITION OF CONDUIT AND BOX.
5. MAXIMUM TIME CABLE MAY REMAIN DISCONNECTED IS TWELVE (12) HOURS IN ONE DAY FROM 7:00AM TO 7:00PM.
6. SEE B/5 FOR CONDUIT AND JUNCTION BOX REPLACEMENT.

D I/O CABLE PRESERVATION NOTES


ALL WORK ON THIS SHEET IS IN ADDITIVE ALTERNATE #1.

1 ADDENDUM 1 - ISSUED 4/1/2026


SHEET TITLE:	ADD. ALT. #1
SCUM PIT HATCH REPLACEMENT	
PROJECT:	WPC 26-4 CAPITAL EQUIPMENT REPLACEMENTS
OWNER:	CITY OF TULSA, OKLAHOMA TULSA METROPOLITAN UTILITY AUTHORITY
ENGINEER:	SAMUEL H. RAY, P.E.
APPROVAL:	<i>Cindy Cantero</i> WPC SECTION MANAGER
ISSUE DATE:	FEBRUARY 12, 2026
SHEET NUMBER:	4 OF 11 SHEETS

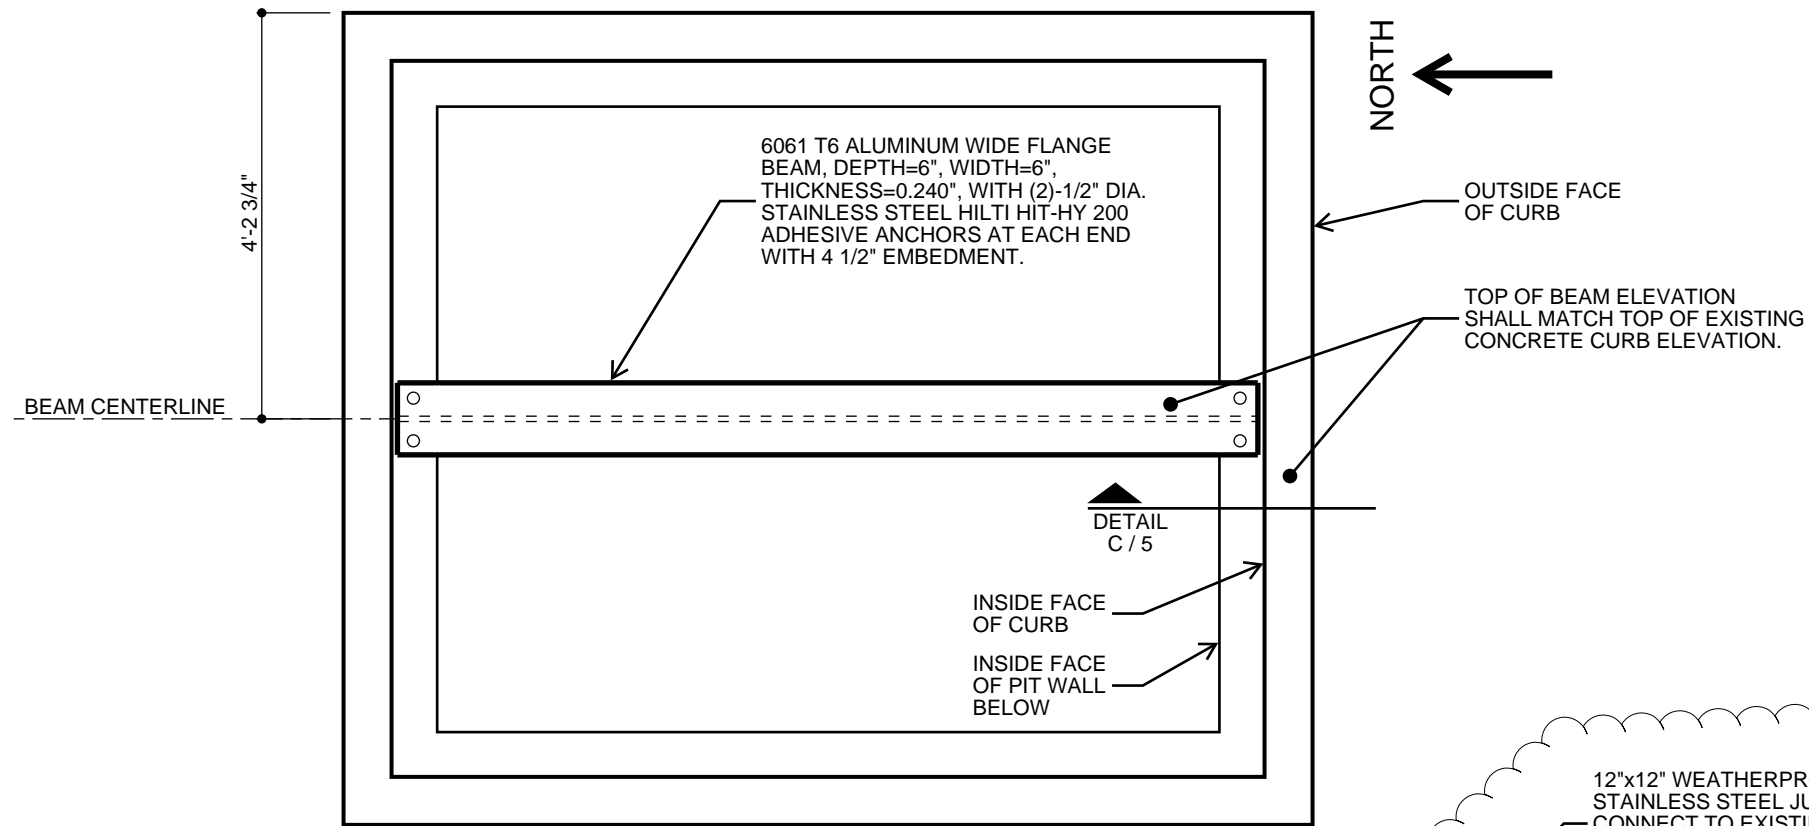

A SCUM PIT FRAMING PLAN

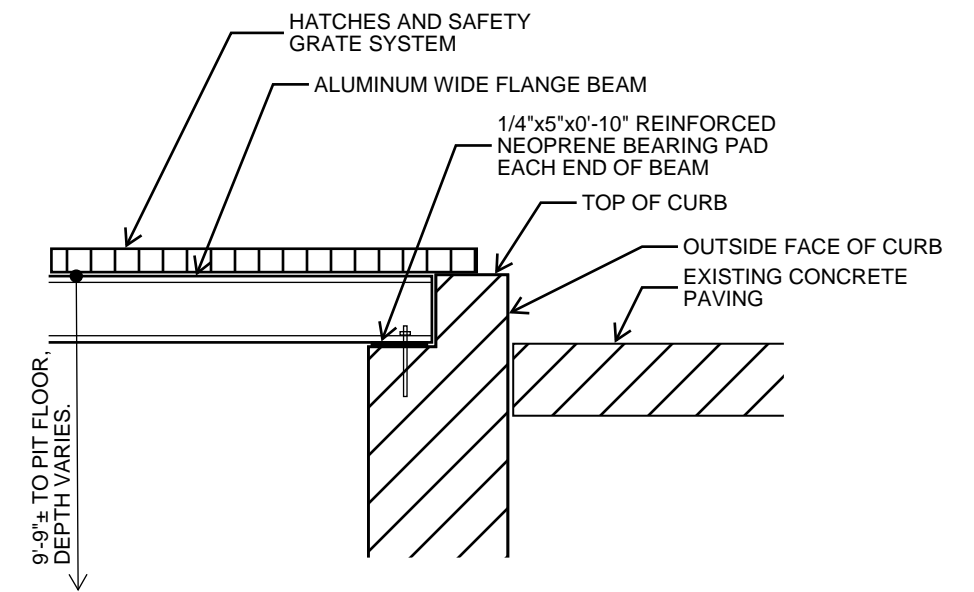

C SCUM PIT DETAIL

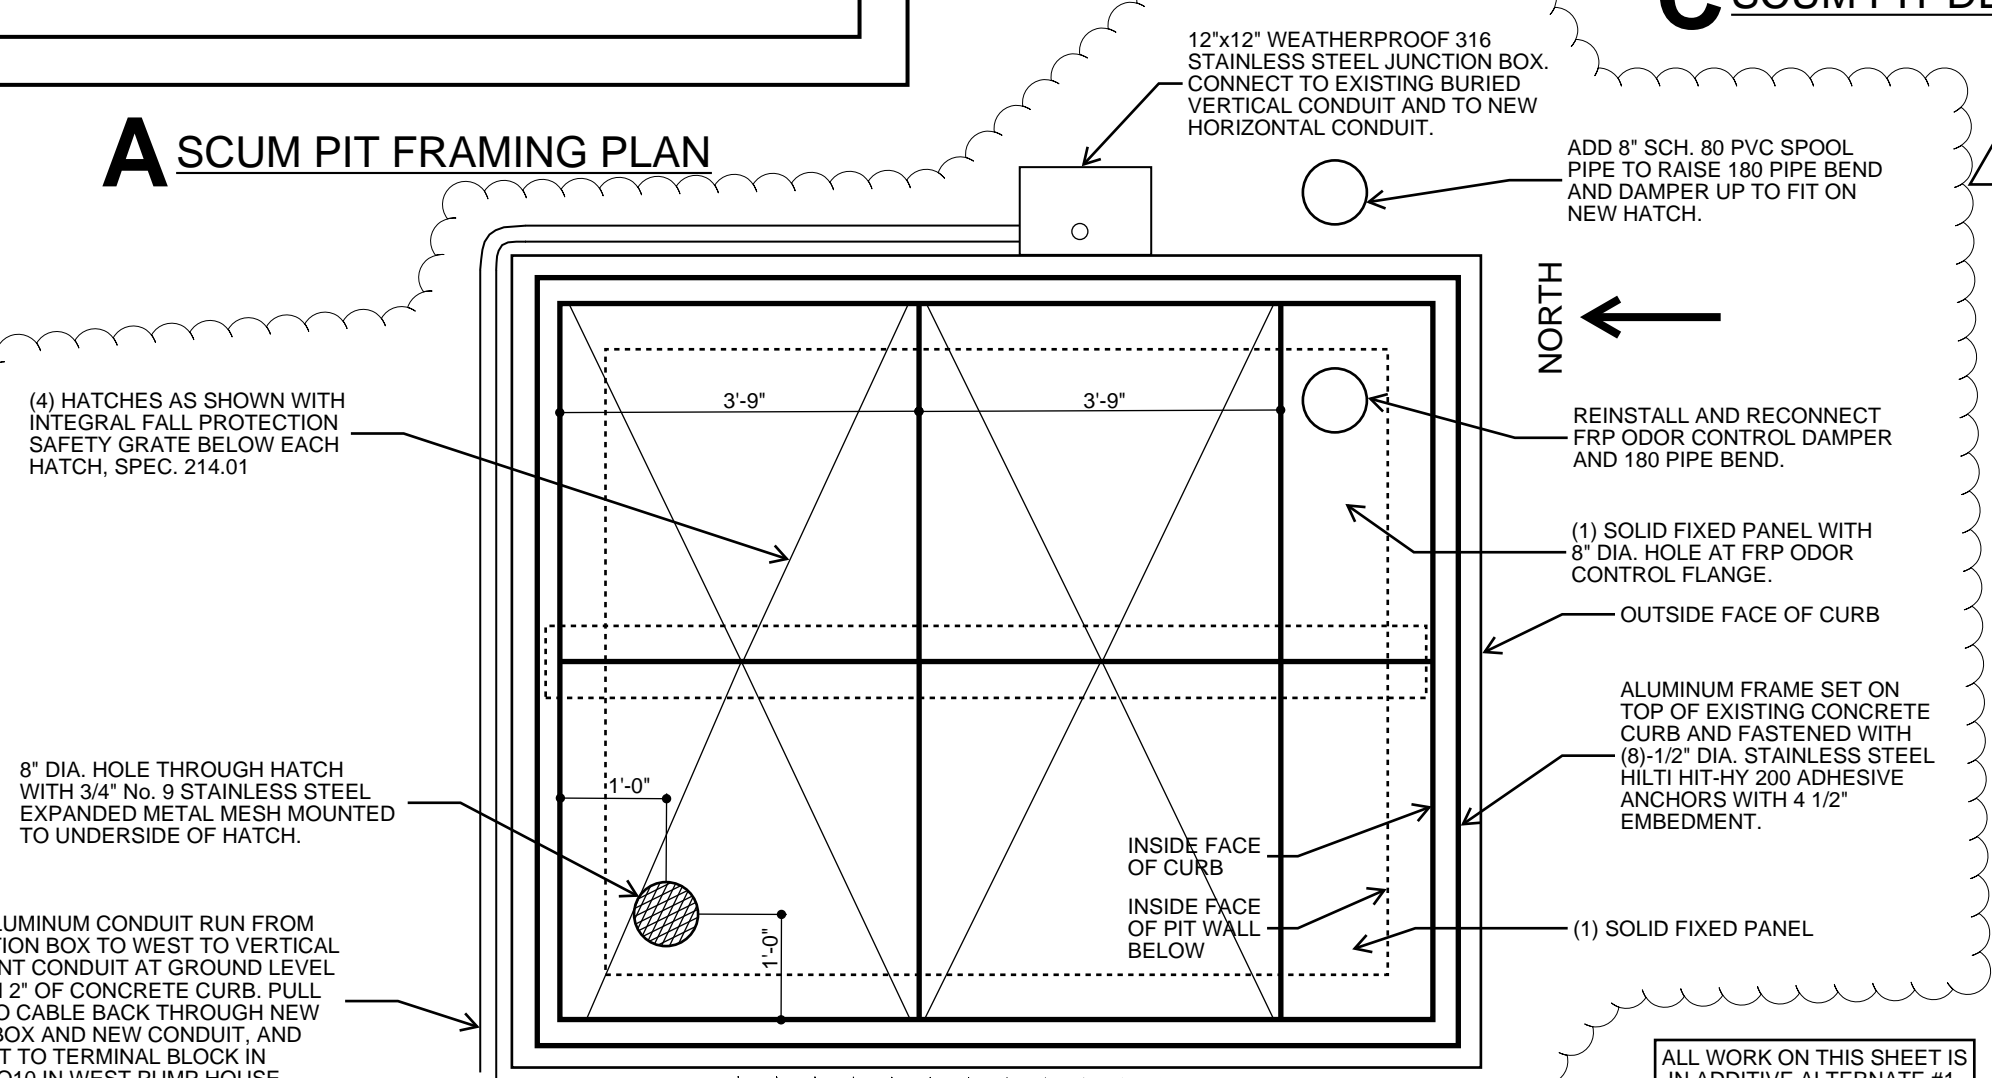

B SCUM PIT HATCH PLAN



SHEET TITLE:	ADD. ALT. #1 SCUM PIT HATCH REPLACEMENT
PROJECT:	WPC 26-4 CAPITAL EQUIPMENT REPLACEMENTS
OWNER:	CITY OF TULSA, OKLAHOMA TULSA METROPOLITAN UTILITY AUTHORITY
ENGINEER:	SAMUEL H. RAY, P.E.
APPROVAL:	<i>Lindy Cantero</i> WPC SECTION MANAGER
ISSUE DATE:	FEBRUARY 12, 2026
SHEET NUMBER:	5 OF 11 SHEETS


ALL WORK ON THIS SHEET IS IN ADDITIVE ALTERNATE #1.

1 ADDENDUM 1 - ISSUED 4/1/2026




VIEW LOOKING WEST

A PHOTO OF EXISTING CC MAKE-UP AIR UNIT

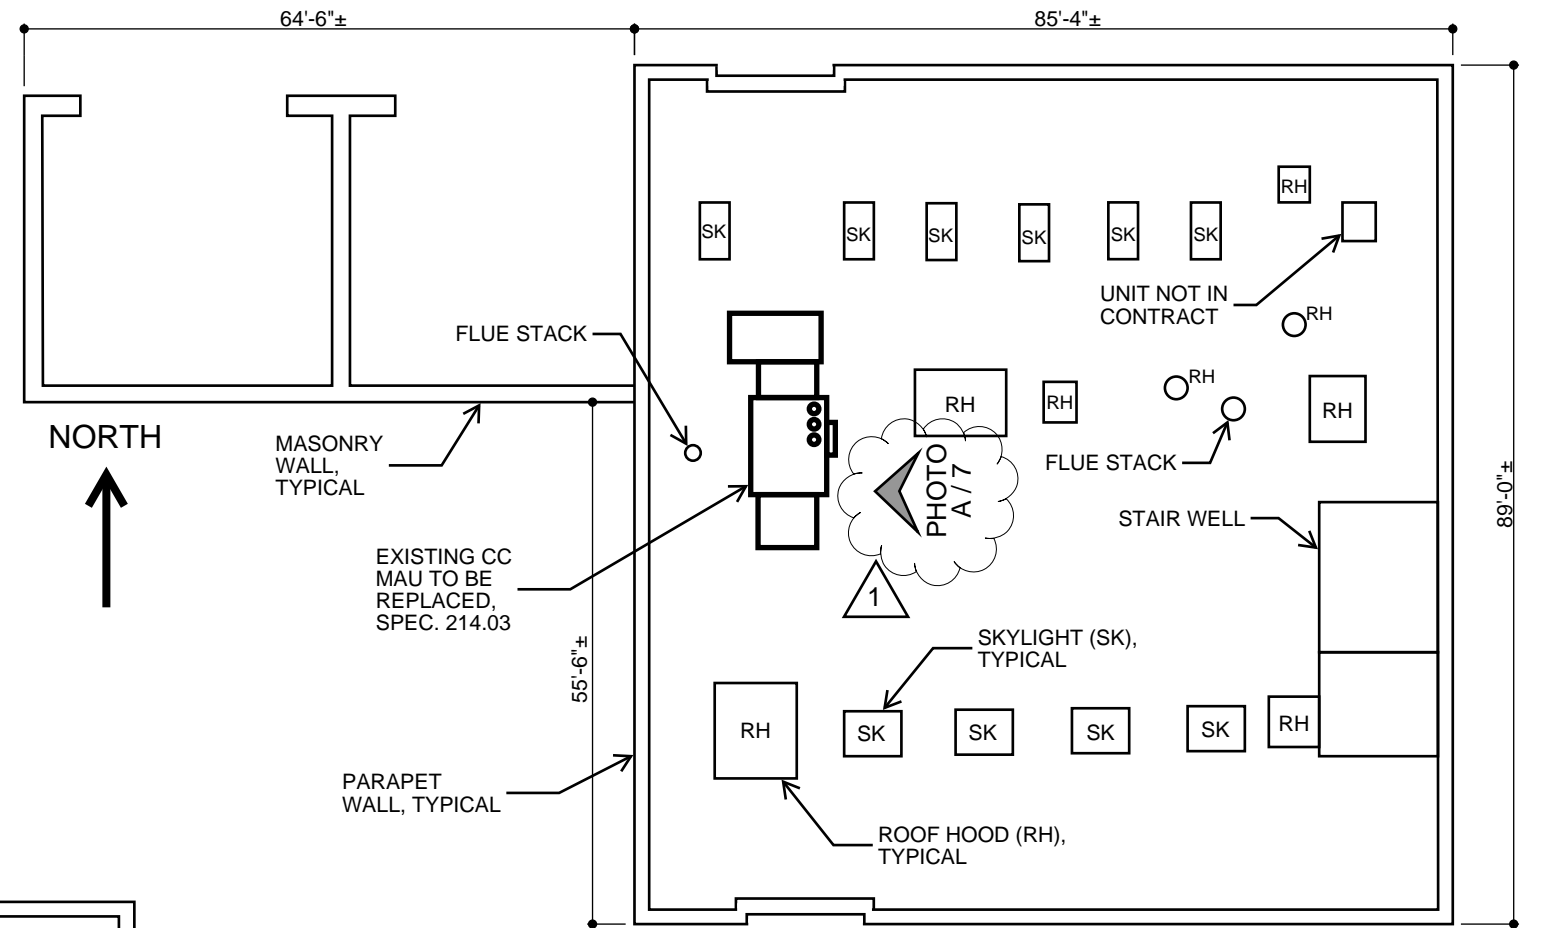

B EXISTING ROOF PLAN

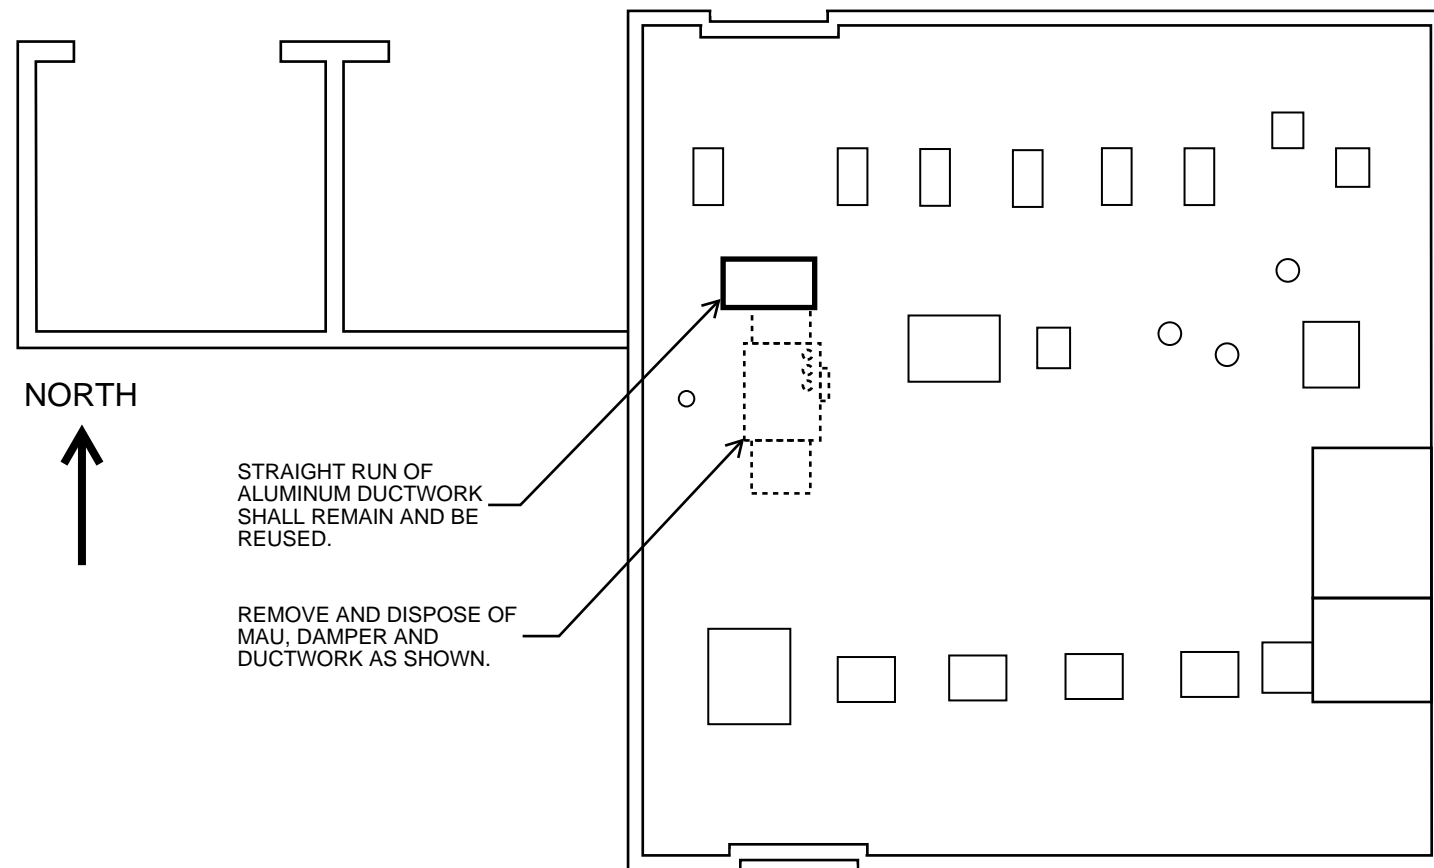

C DEMOLITION ROOF PLAN



SHEET TITLE:	CC MAKE-UP AIR UNIT REPLACEMENT
PROJECT:	WPC 26-4 CAPITAL EQUIPMENT REPLACEMENTS
OWNER:	CITY OF TULSA, OKLAHOMA TULSA METROPOLITAN UTILITY AUTHORITY
ENGINEER:	SAMUEL H. RAY, P.E.
APPROVAL:	<i>Cindy Cantero</i> WPC SECTION MANAGER
ISSUE DATE:	FEBRUARY 12, 2026
SHEET NUMBER:	7 OF 11 SHEETS

1 ADDENDUM 1 - ISSUED 4/1/2026